


TOTAL SF AVAILABLE - 5,776 RSF

OFFICE - 5,776 RSF


WAREHOUSE - 0,000 SF

INCLUDES % OF METER ROOM

[Click to access 3D model](#)

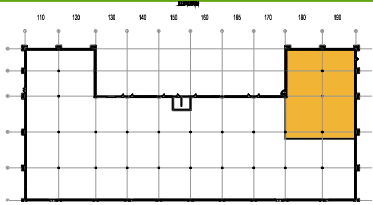

Key Plan

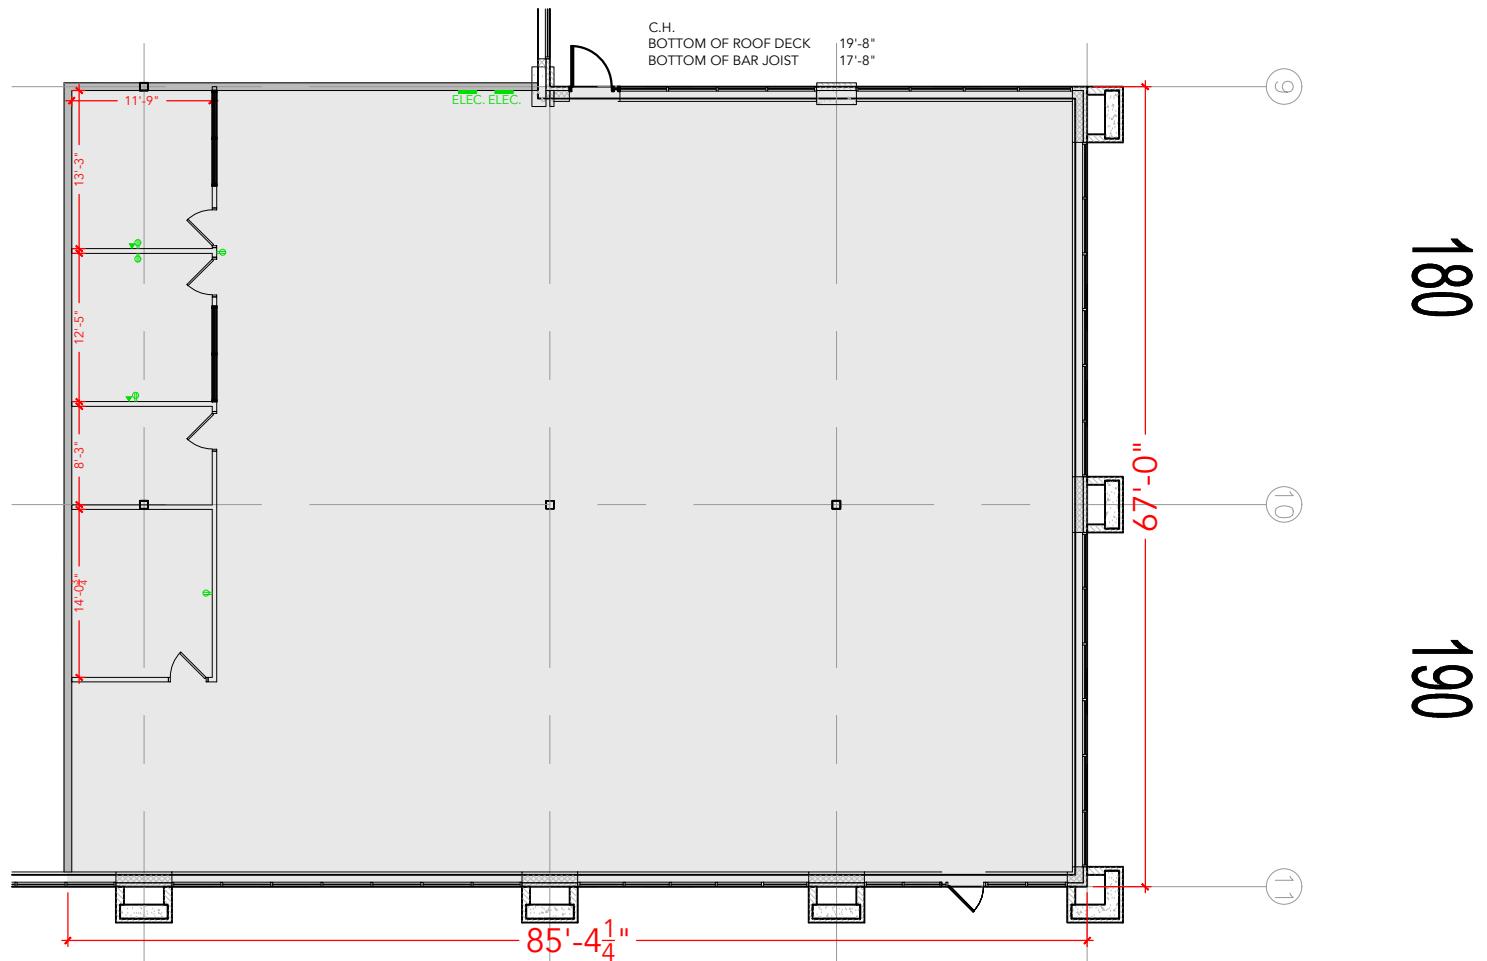

Floor Plan