


TOTAL SF AVAILABLE - 9,445 RSF

OFFICE - 1,242 RSF


WAREHOUSE - 8,203 RSF

* INCLUDES % OF METER ROOM

[Click to access 3D model](#)

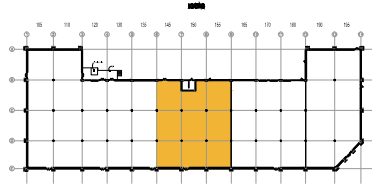

Key Plan

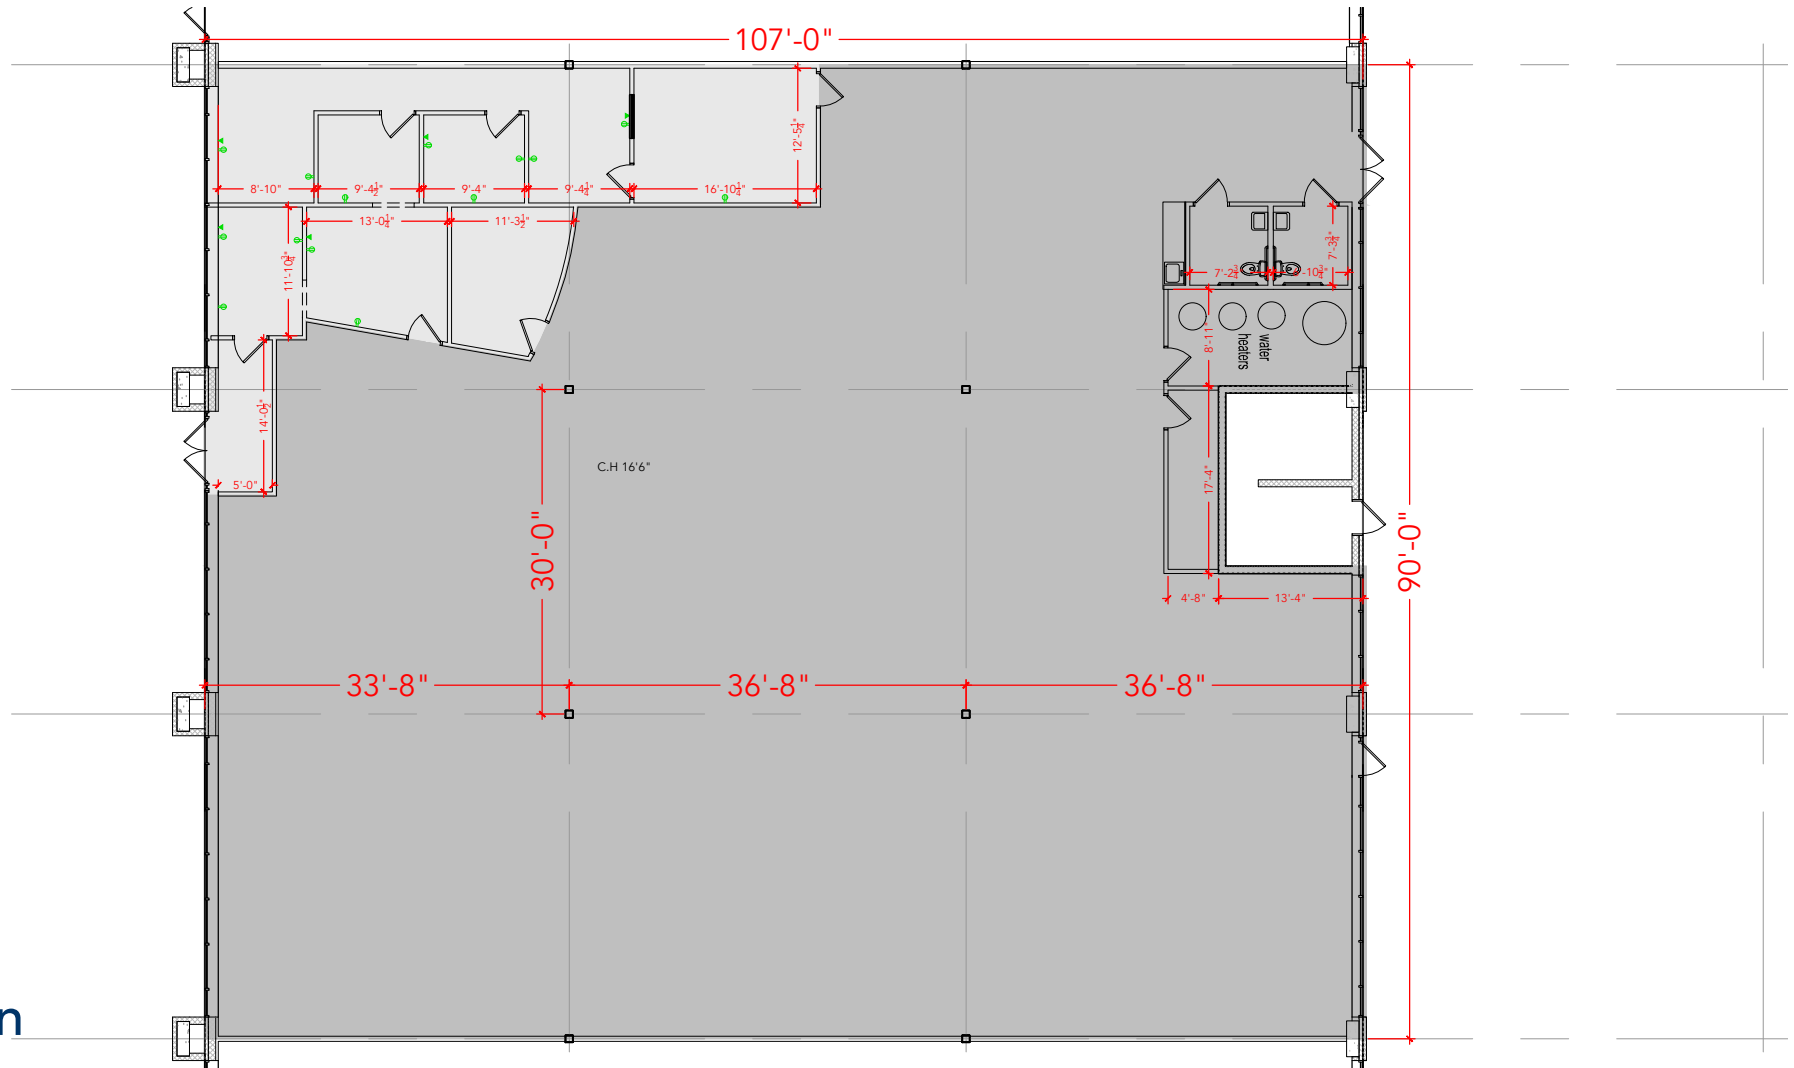

Floor Plan