



TOTAL SF AVAILABLE - 9,476 RSF(12%)

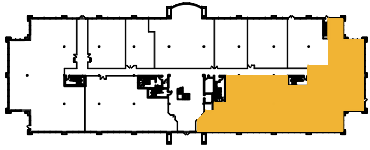

Key Plan

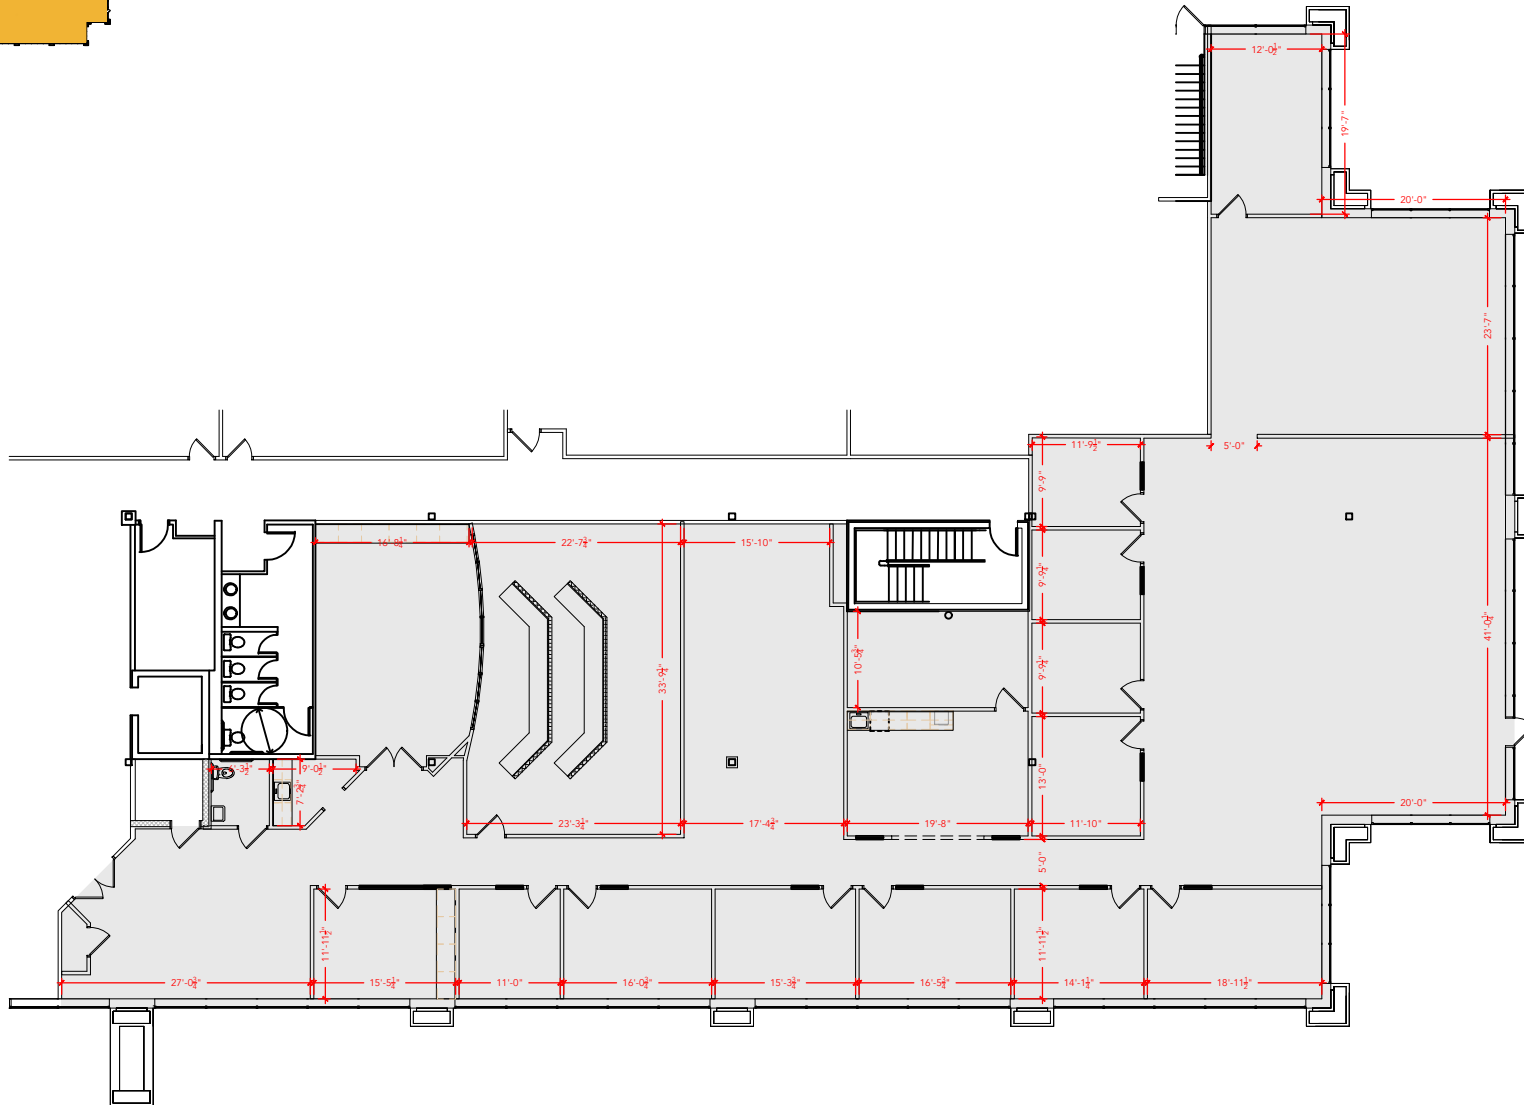

Floor Plan