


TOTAL SF AVAILABLE - 1,624 RSF(12%)



[Click to access 3D model](#)

Key Plan

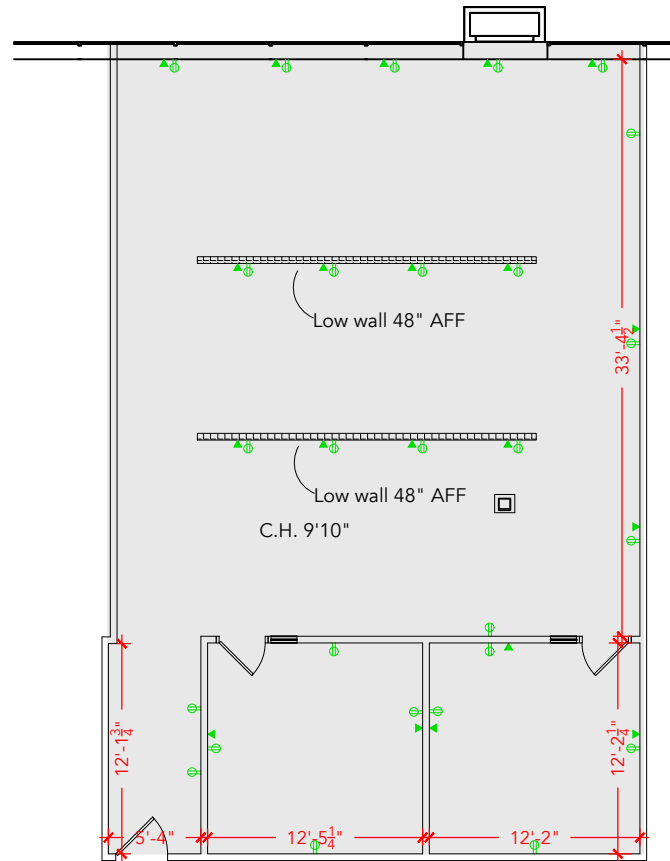

Floor Plan