



TOTAL SF AVAILABLE -11,495 RSF (12%)

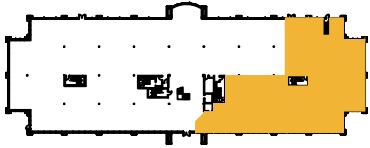

Key Plan

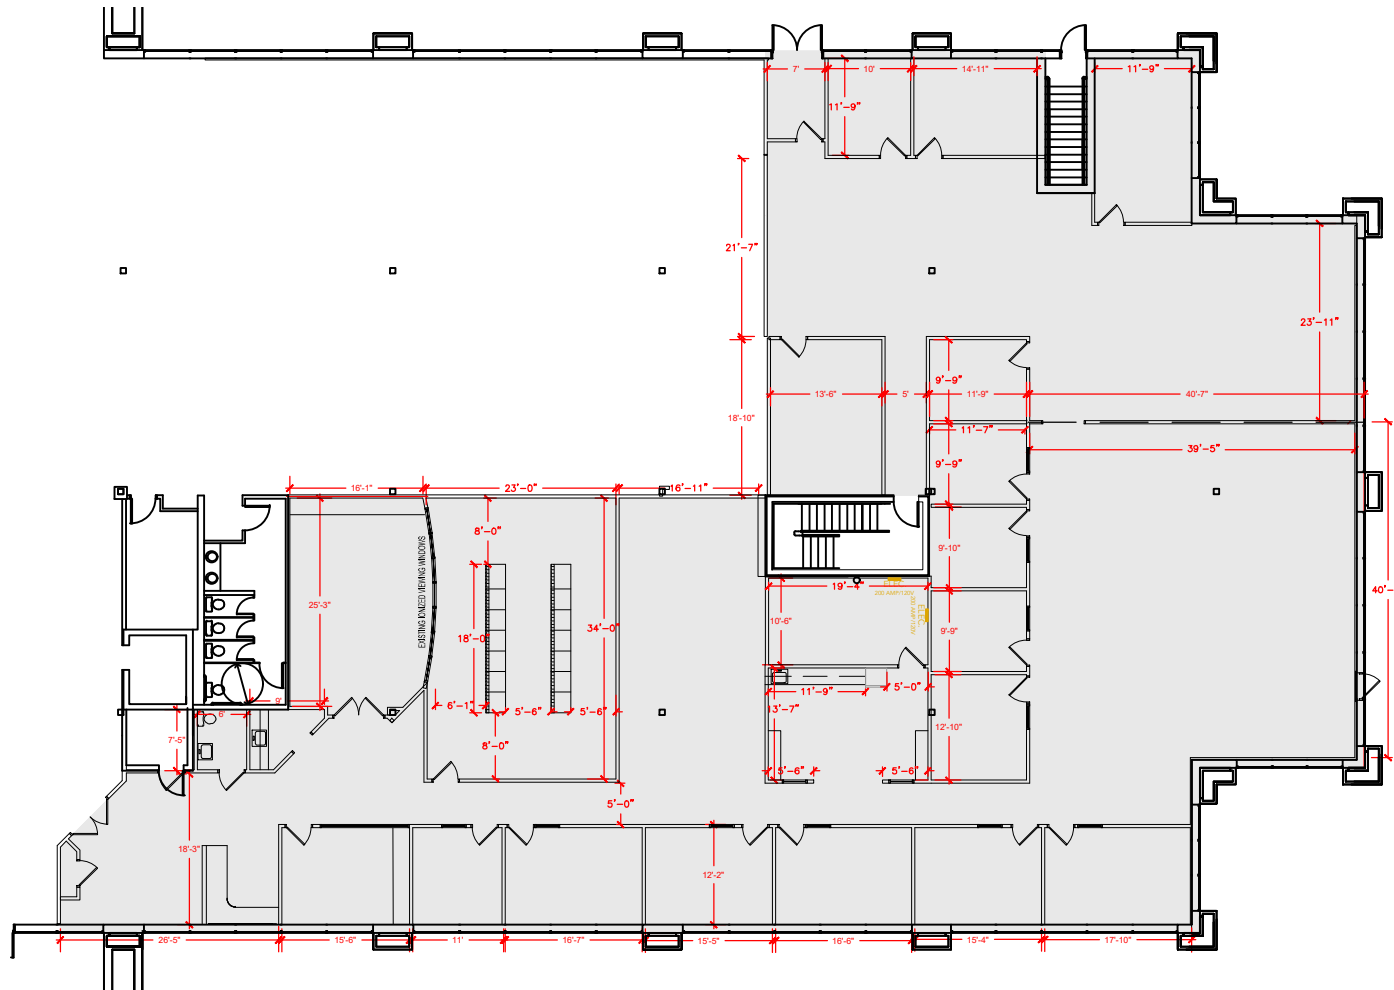

## Floor Plan