



TOTAL SF AVAILABLE - 2,918 RSF(12%)

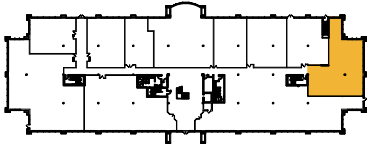

Key Plan

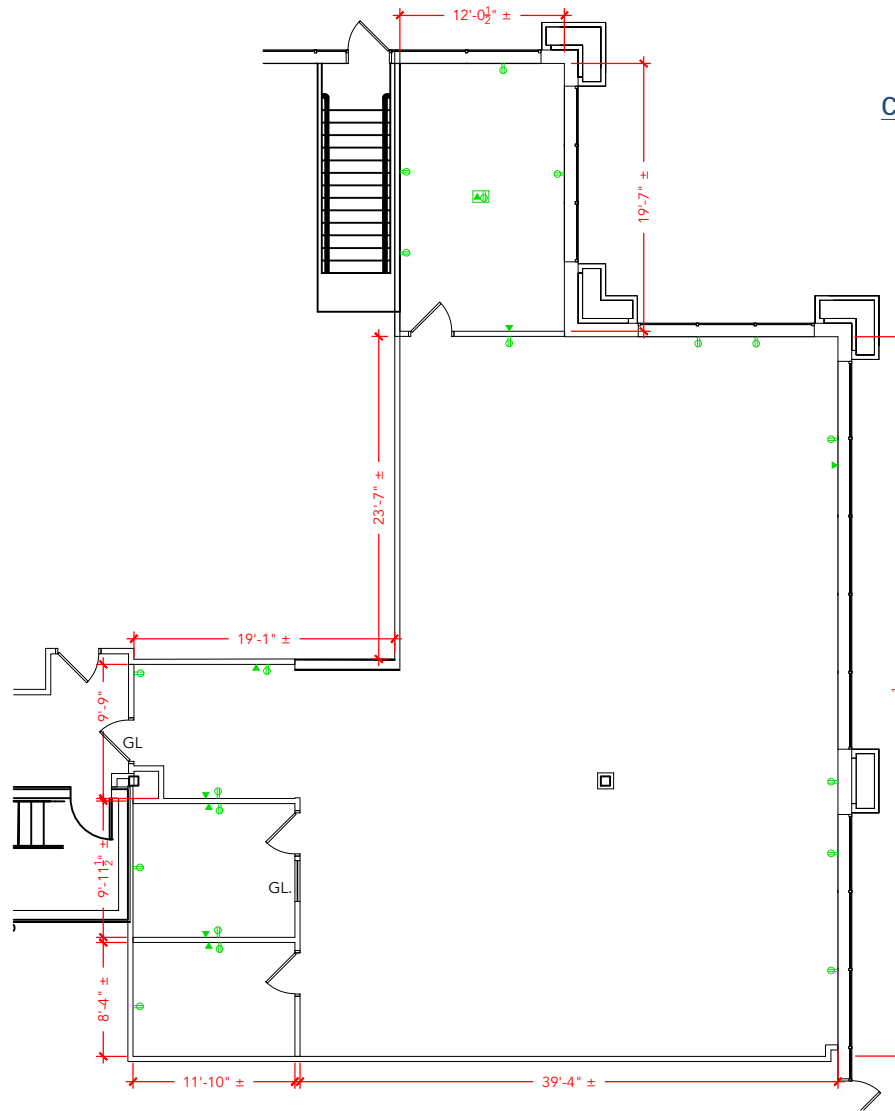

[Click to access 3D model](#)

## Floor Plan