


Key Plan

TOTAL SF AVAILABLE - 1,624 RSF

OFFICE - 1,624 SF

WAREHOUSE - 0,000 SF

[Click to access 3D model](#)

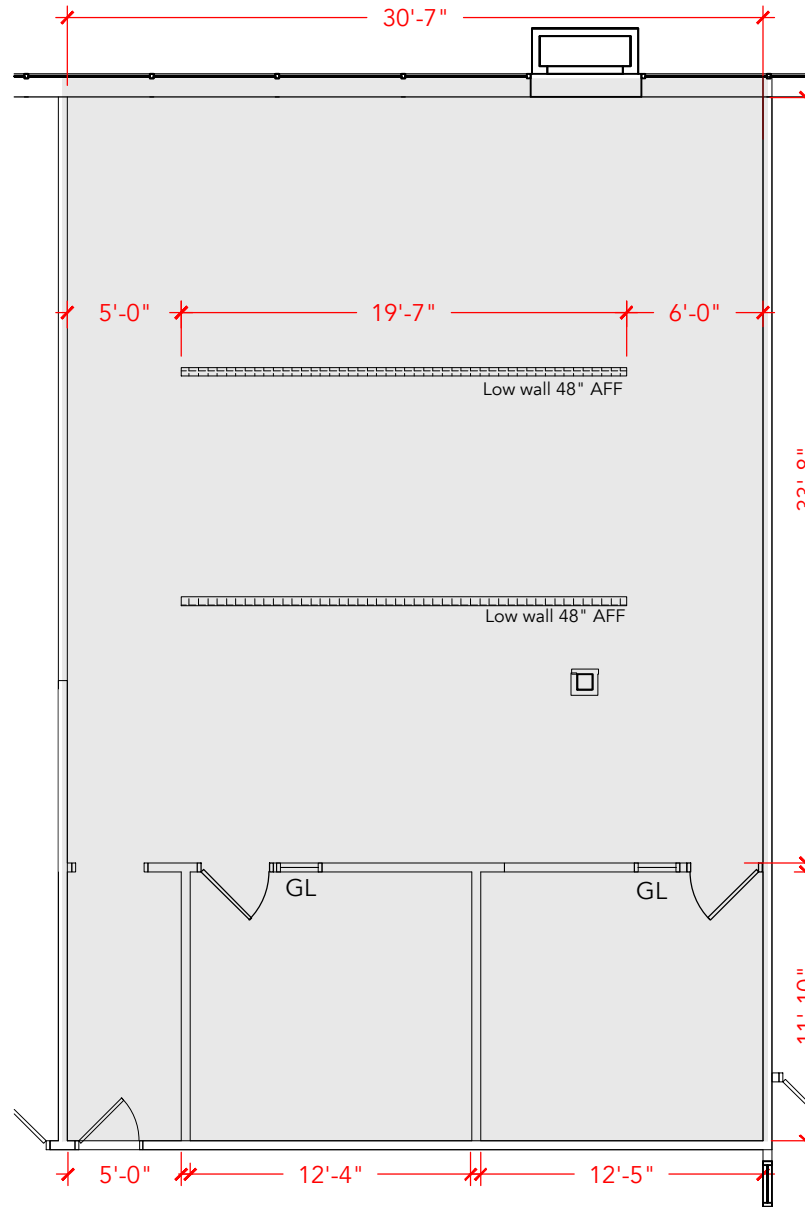

Floor Plan