


ASHBROOK 20098 ASHBROOK PLACE, ASHBURN, VA 20147 SUITE 220

TOTAL SF AVAILABLE - 2,811 RSF (12%)

Click to access 3D model

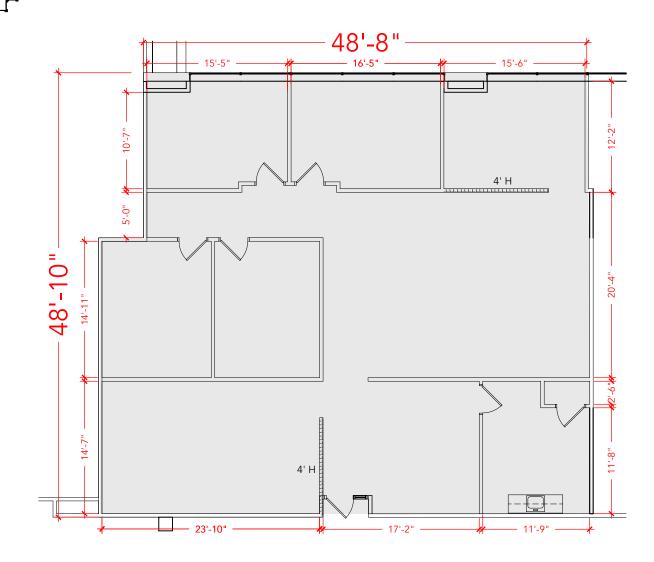

Key Plan

Floor Plan