



TOTAL SF AVAILABLE - 3,506 RSF

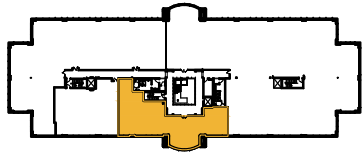

Key Plan

[Click to access 3D model](#)

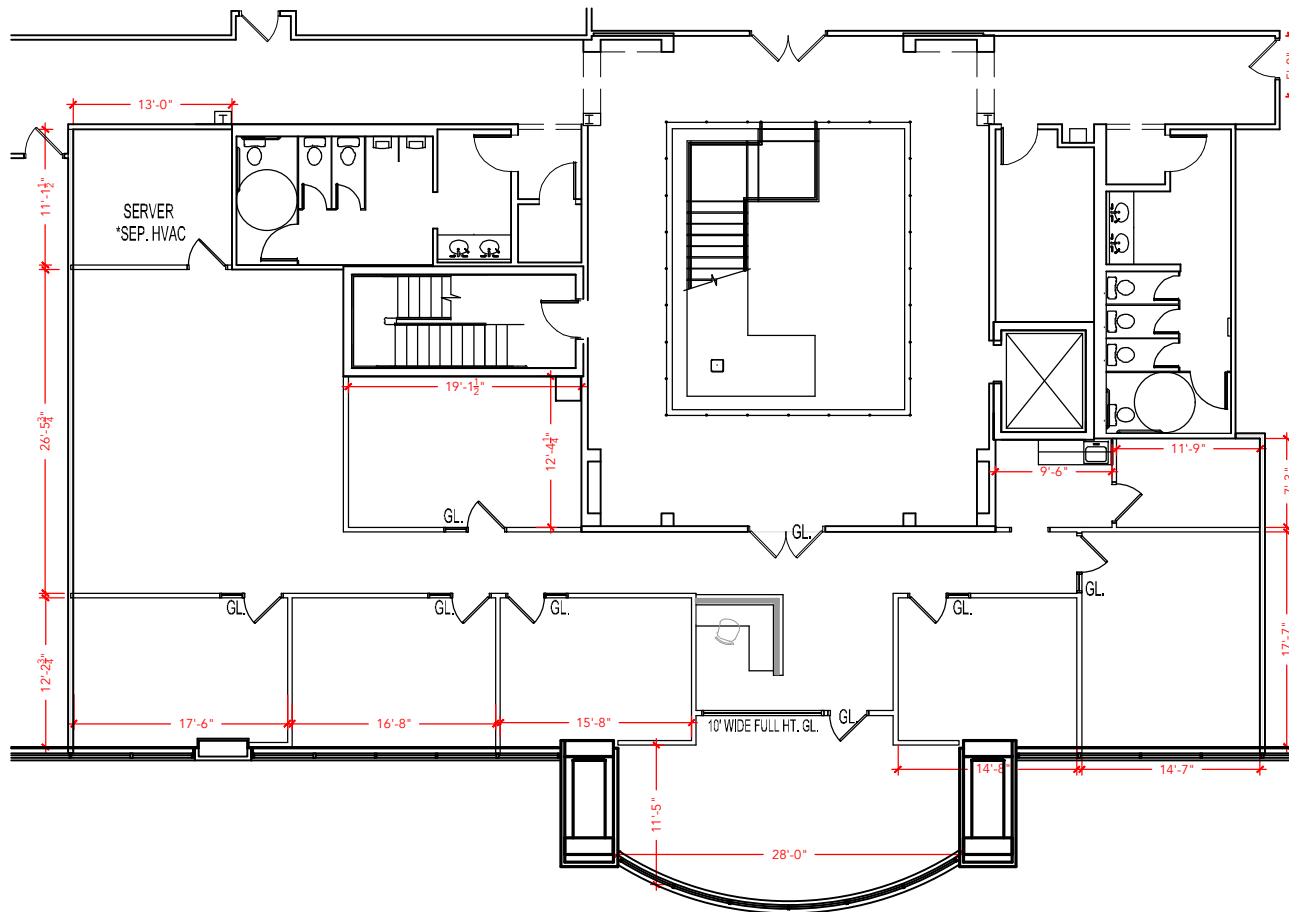

## Floor Plan