


## **ASHBROOK**


20116 ASHBROOK PLACE ASHBURN, VA 20147 SUITE 210-240

## TOTAL SF AVAILABLE - 12,432 RSF(12%)

Click to access3D model

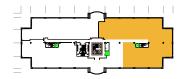

Key Plan

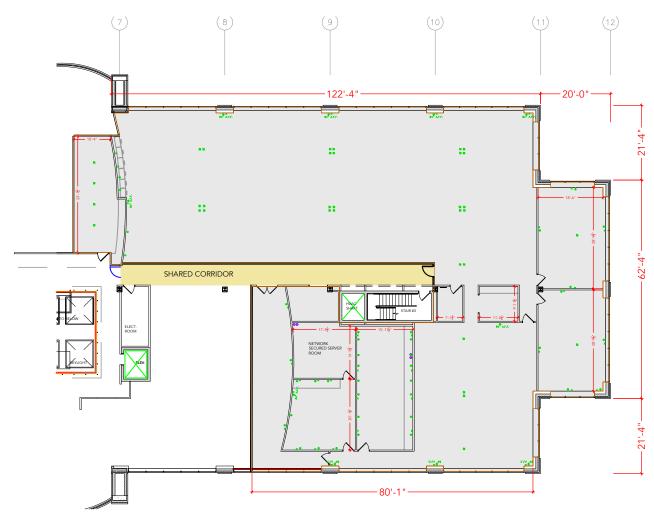

## Floor Plan