


TOTAL SF AVAILABLE - 3,165 RSF

OFFICE - 0,000 RSF


WAREHOUSE - 3,165 RSF

* INCLUDES % OF METER ROOM

[Click to access 3D model](#)

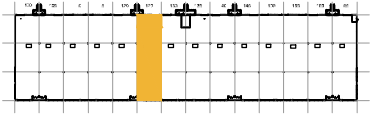

Key Plan

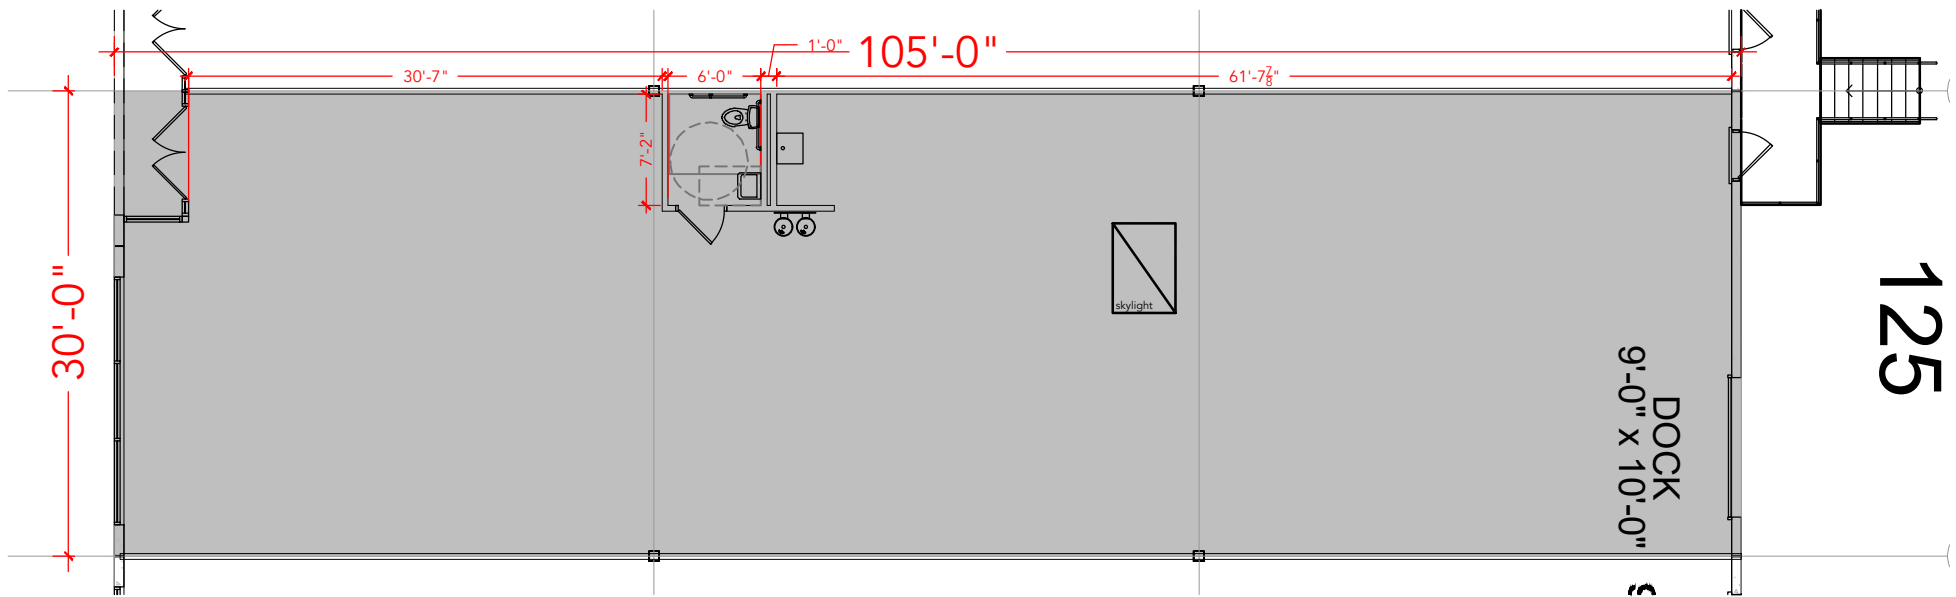

Floor Plan