


TOTAL SF AVAILABLE - 6,172 RSF

OFFICE - 3,406 RSF


WAREHOUSE SF - 2,776 RSF

* INCLUDES % OF METER ROOM

[Click to access 3D model](#)

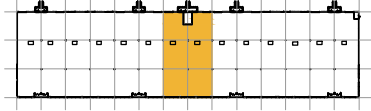

Key Plan

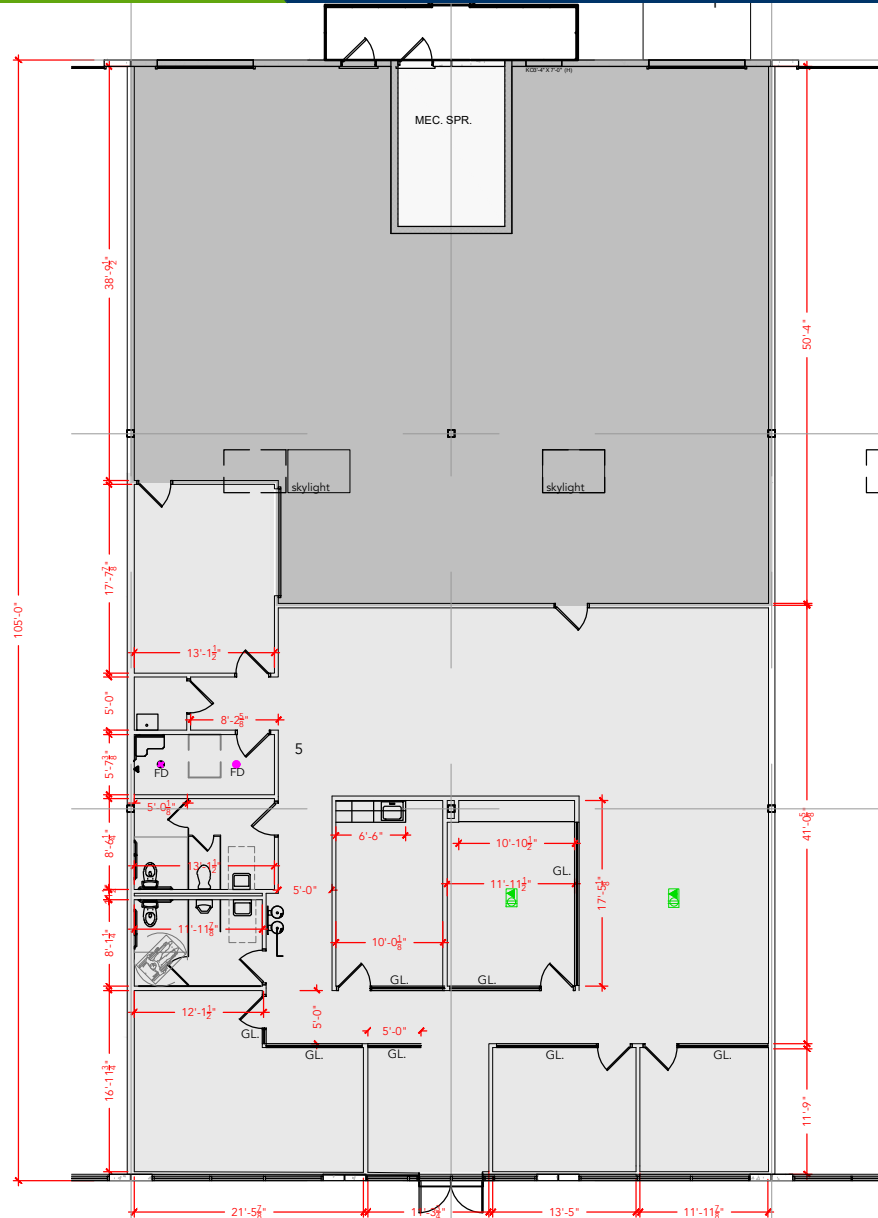

Floor Plan