



TOTAL SF AVAILABLE -6,281 RSF

OFFICE RSF- 0,000 RSF

WAREHOUSE RSF - 6,281 RSF
*INCLUDED % OF METER ROOM
[Click to access 3D model](#)

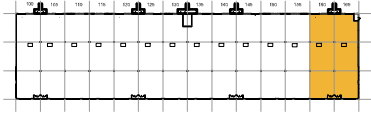

Key Plan

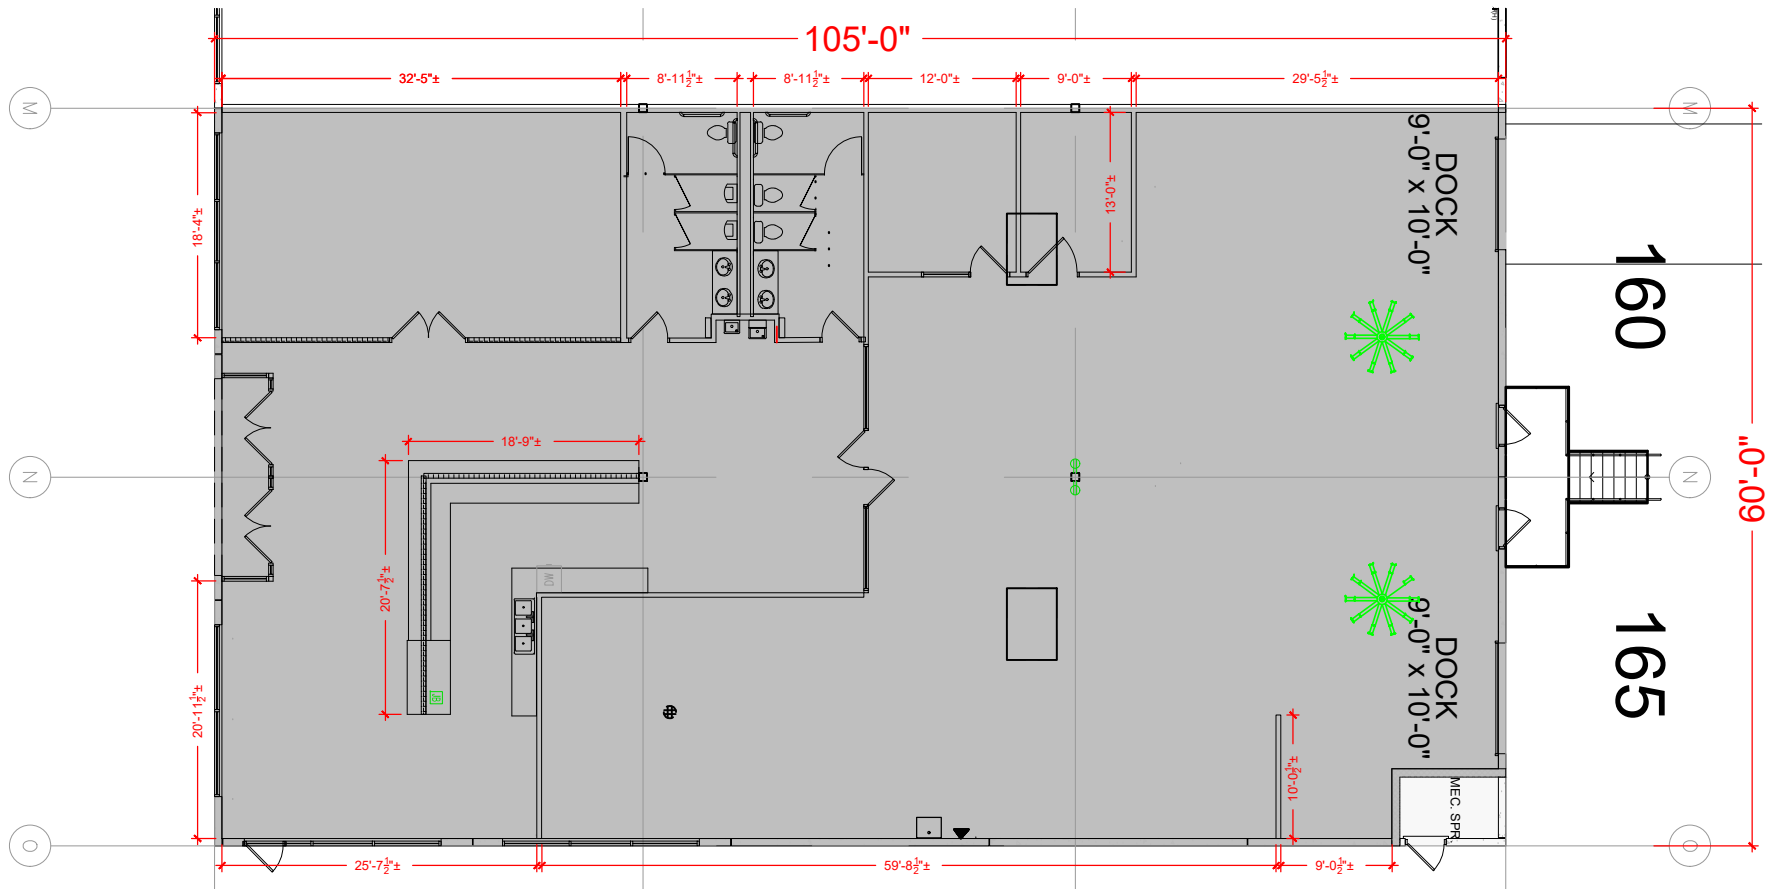

Floor Plan