



TOTAL SF AVAILABLE -2,700 SF

WAREHOUSE - 2,700 SF

[Click to access 3D model](#)

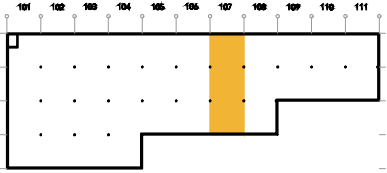

Key Plan

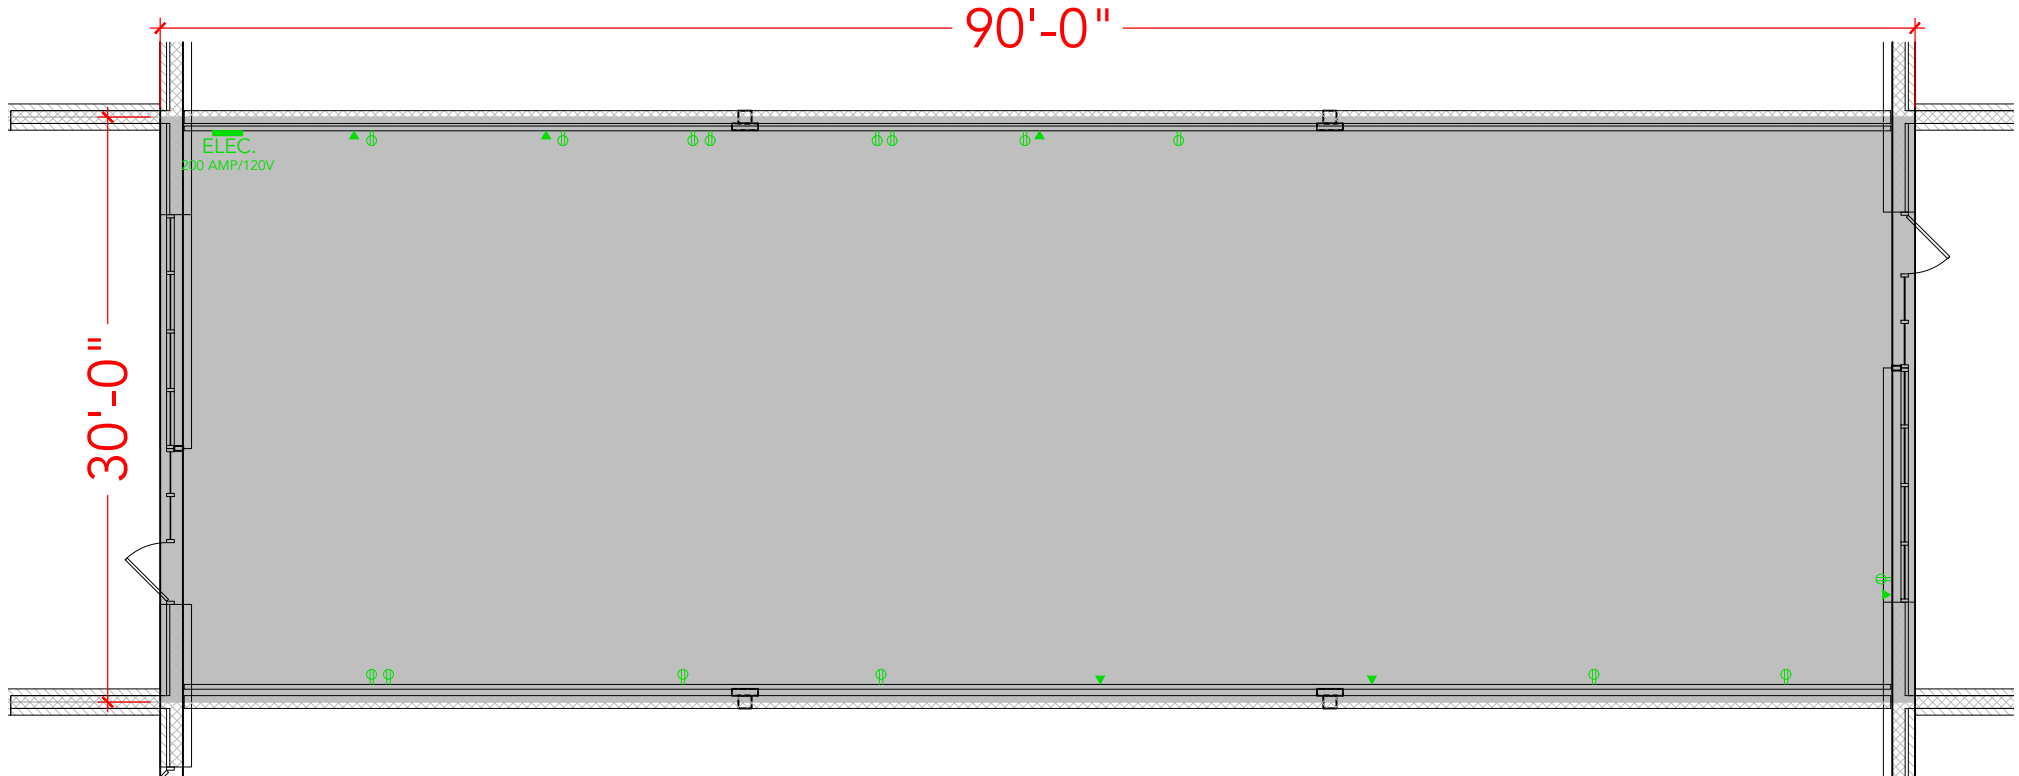

Floor Plan