



TOTAL SF AVAILABLE - 2,700 SF

OFFICE - 2,700 SF
WAREHOUSE SF - 0,000 SF

[Click to access 3D model](#)

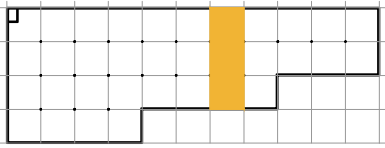

Key Plan

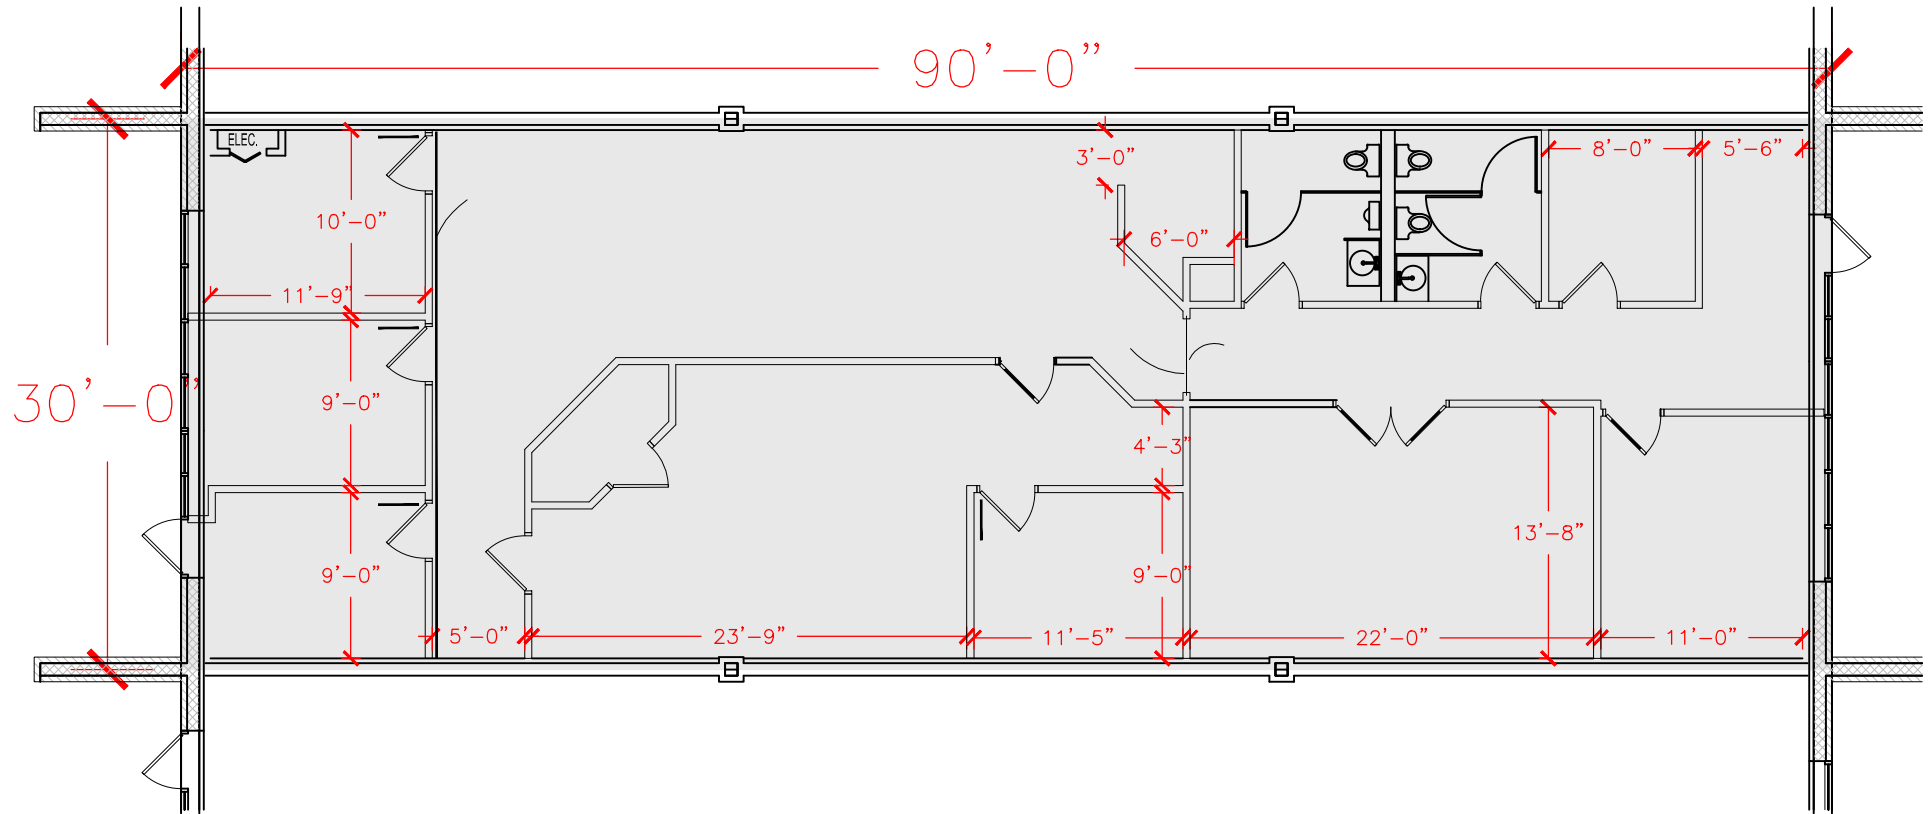

Floor Plan