


**TOTAL SF AVAILABLE -2,700 SF**

**OFFICE - 0,000 SF**

**WAREHOUSE - 2,700 SF**

[Click to access CADD file](#)

Key Plan

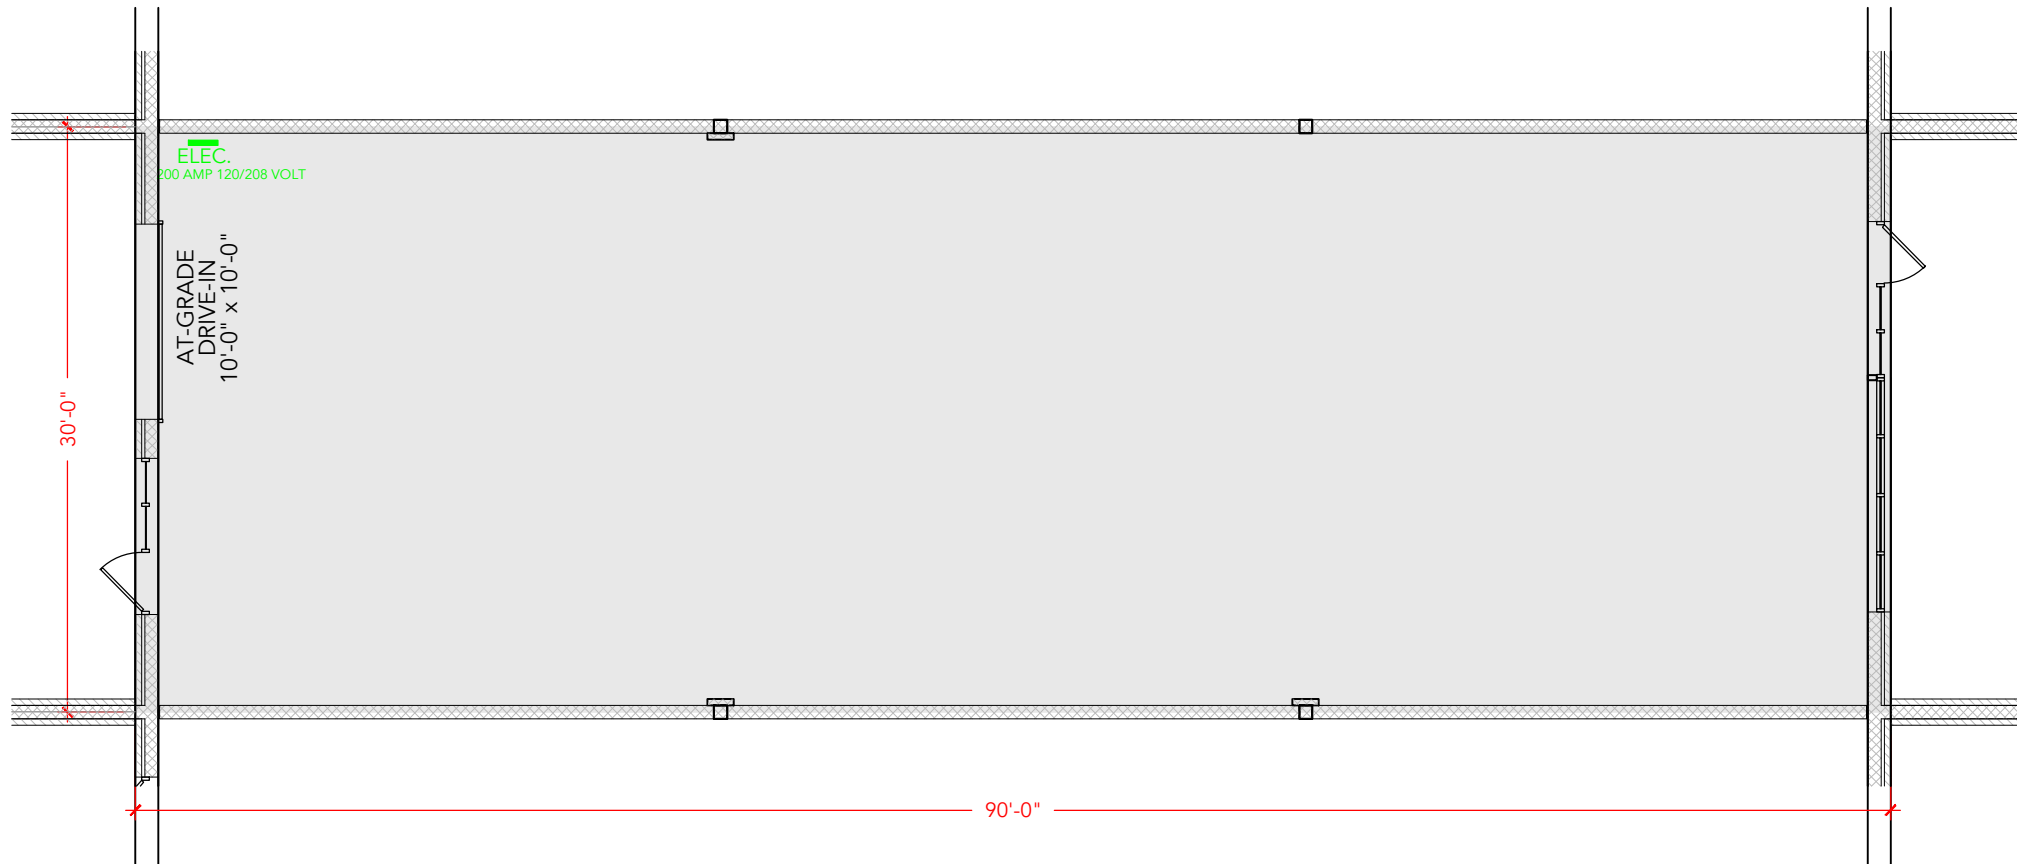

Floor Plan