



**TOTAL SF AVAILABLE - 5,700 SF**

OFFICE - 3,900 SF  
WAREHOUSE - 1,800 SF

[Click to access 3D model](#)

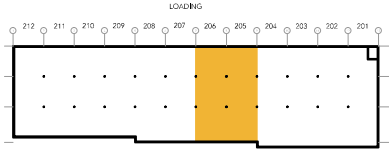

Key Plan

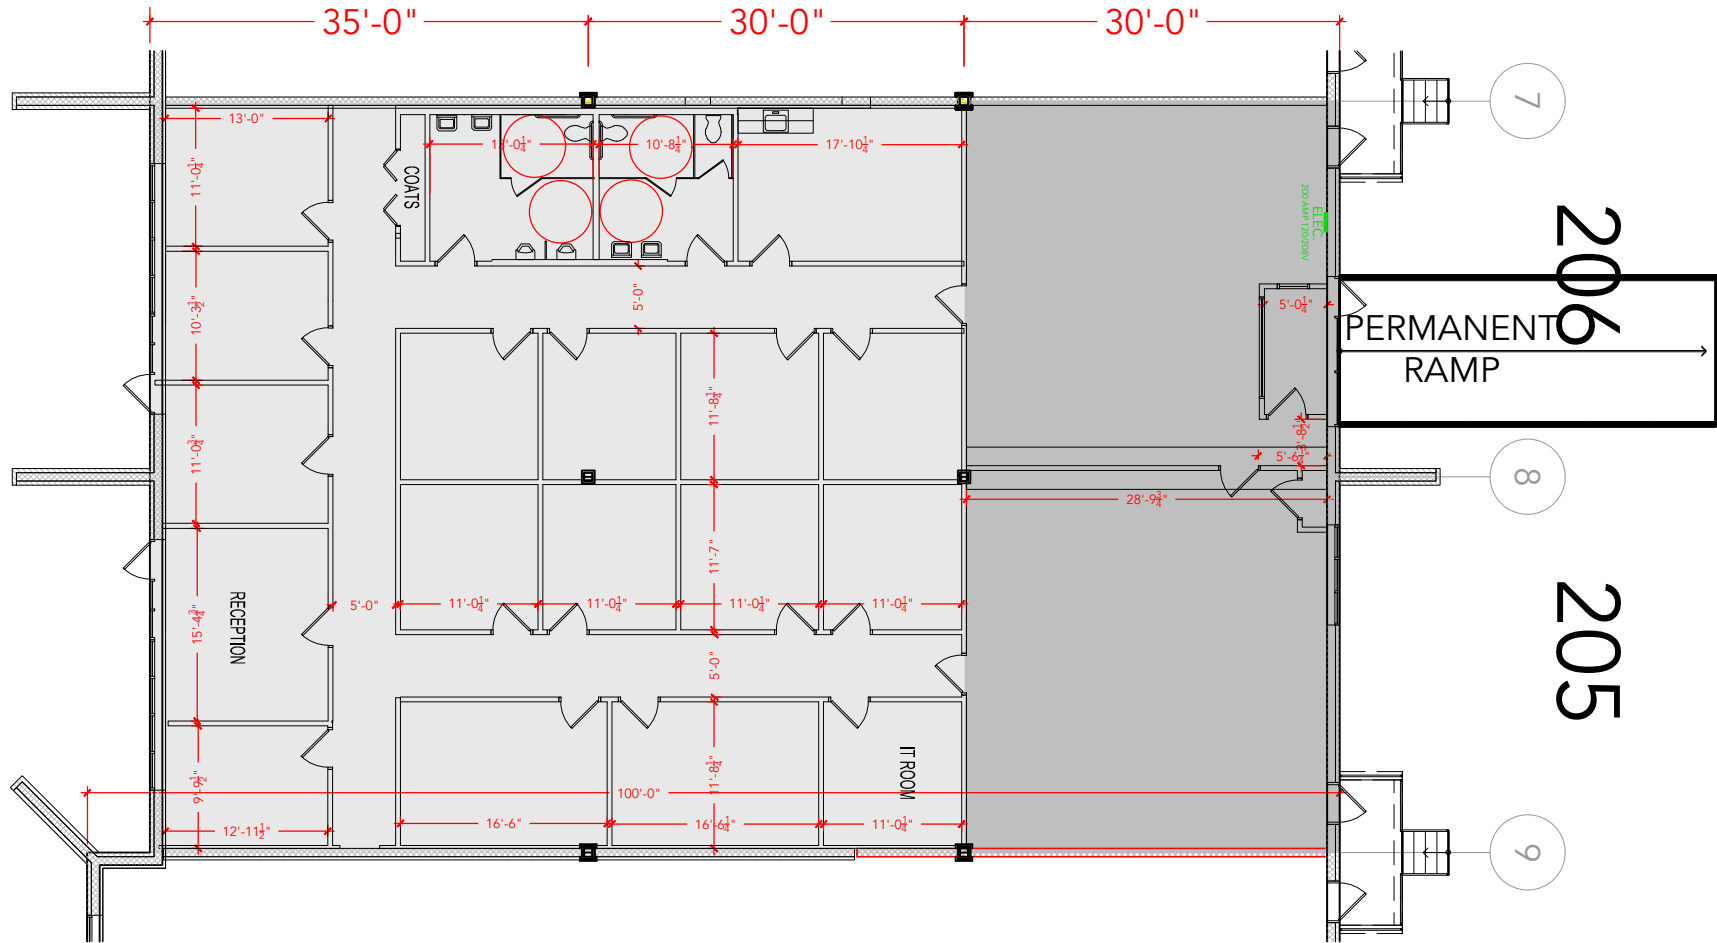

Floor Plan