


TOTAL SF AVAILABLE - 2,700 SF


OFFICE - 1,822 SF

WAREHOUSE - 878 SF

[Click to access 3D model](#)

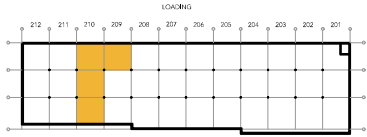

Key Plan

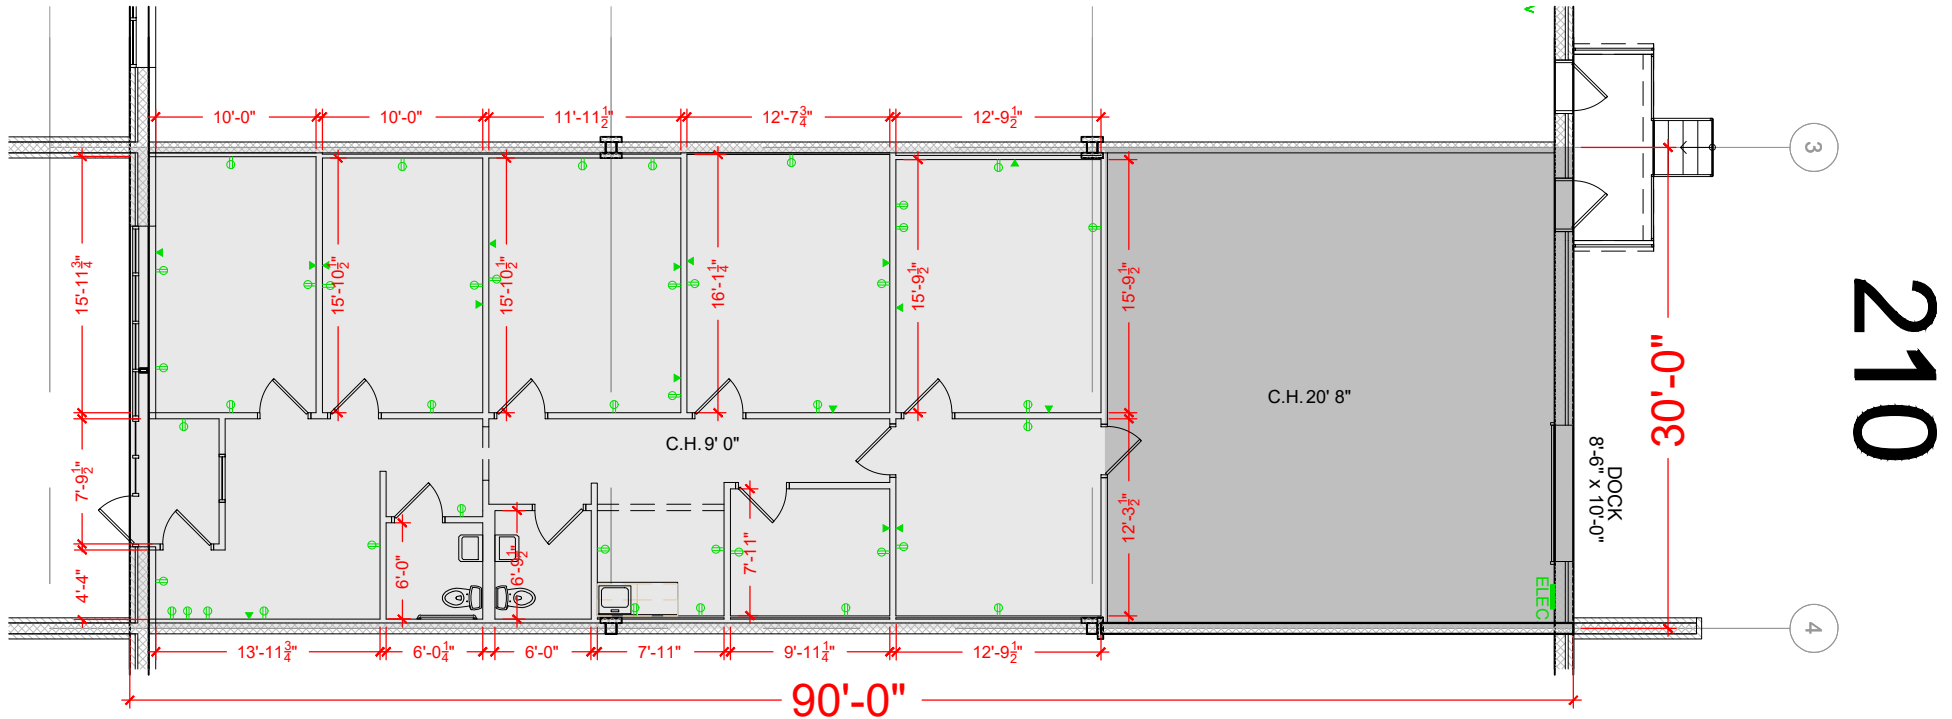

Floor Plan