


TOTAL SF AVAILABLE - 3,000 SF


OFFICE - 2,442 SF

WAREHOUSE SF - 558 SF

[Click to access 3D model](#)

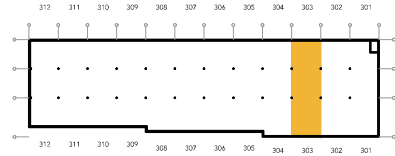

Key Plan

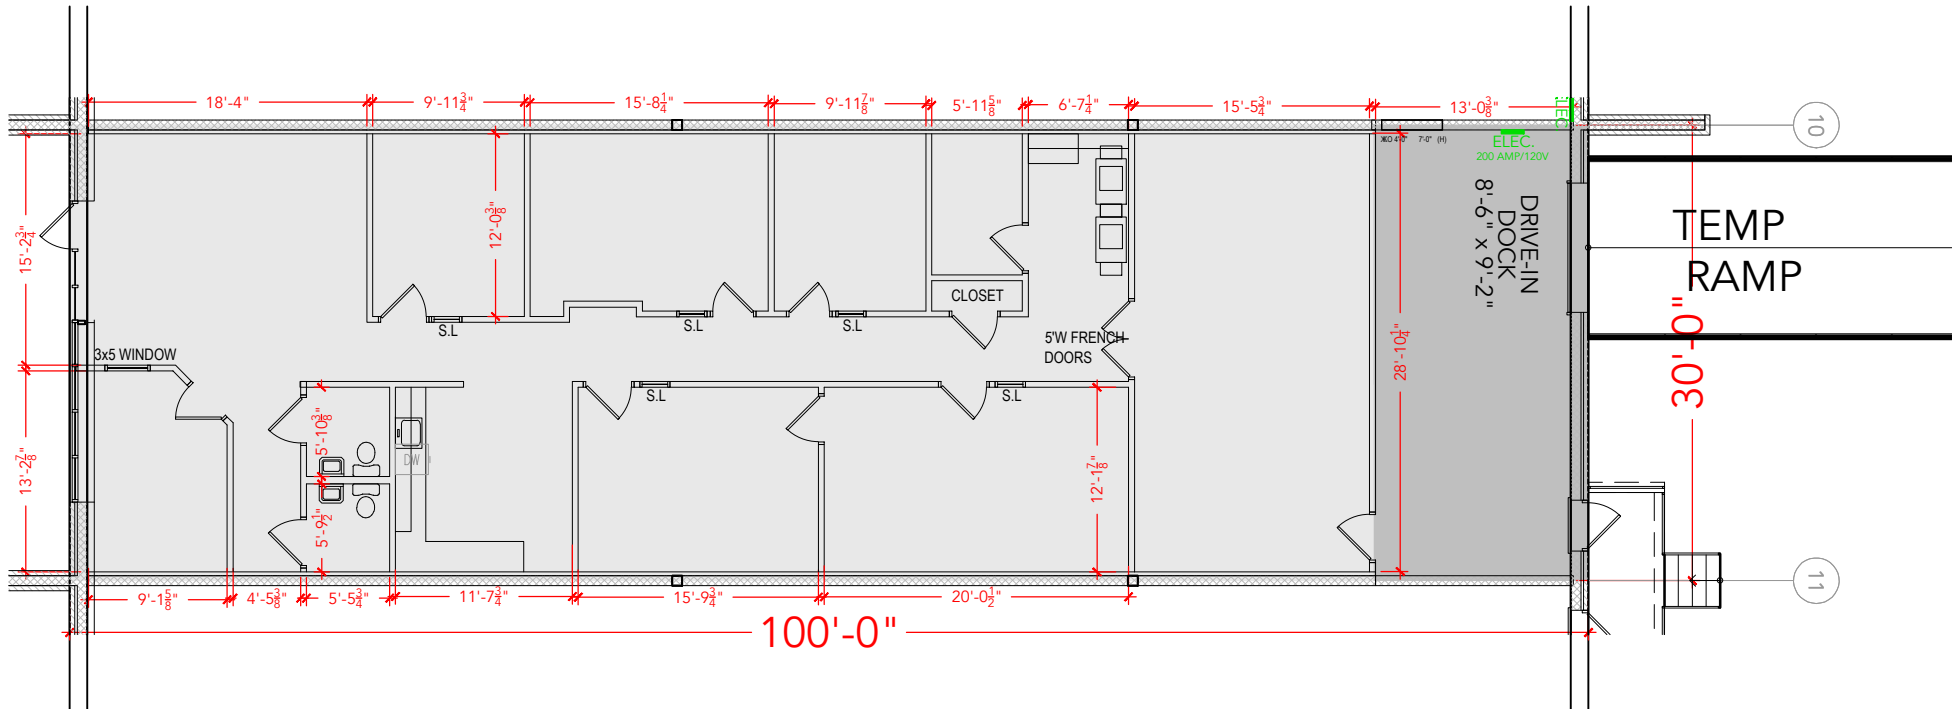

Floor Plan