

TOTAL SF AVAILABLE - 3,000 SF


OFFICE - 493 SF

WAREHOUSE SF - 2,507 SF

[Click to access 3D model](#)



Key Plan

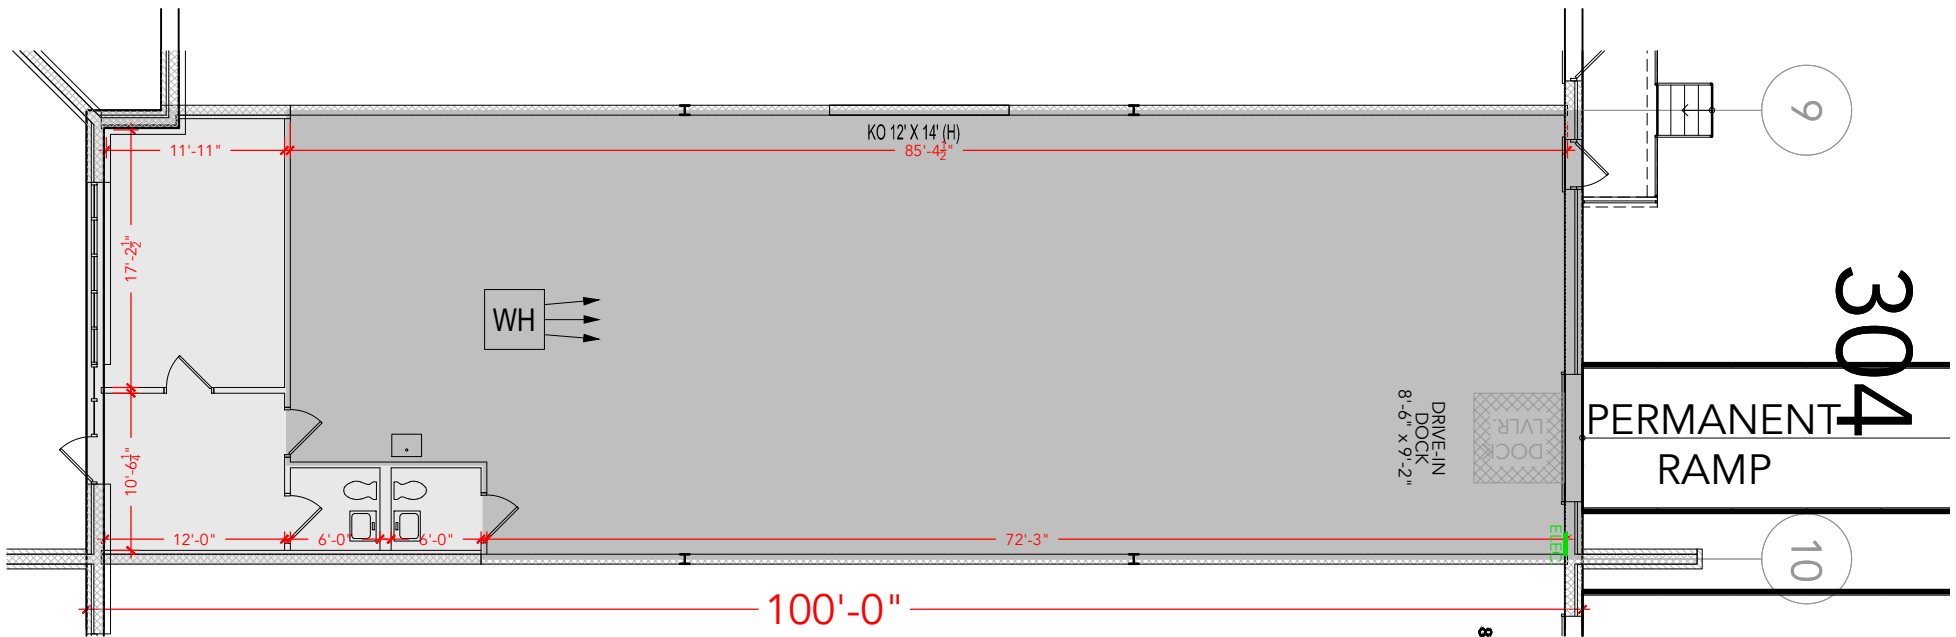

Floor Plan