


TOTAL SF AVAILABLE - 2,700 SF

OFFICE - 0,000 SF
WAREHOUSE SF - 2,700 SF

[Click to access 3D model](#)



Key Plan

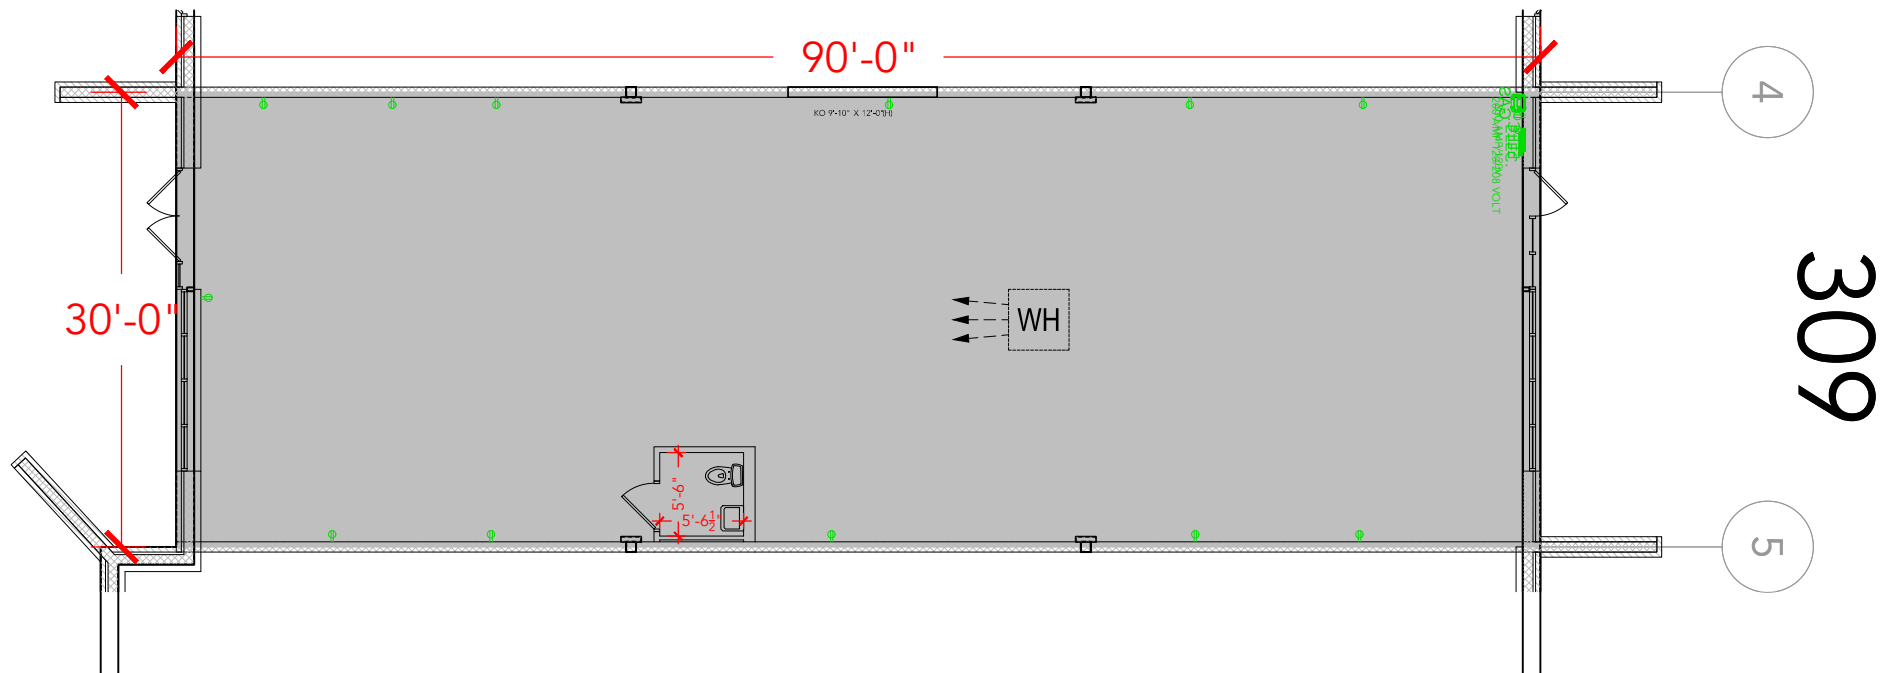

Floor Plan