


TOTAL SF AVAILABLE -2,709 RSF

OFFICE - 2,373 RSF


WAREHOUSE - 339 RSF

* INCLUDES % OF METER ROOM

[Click to access CADD file](#)

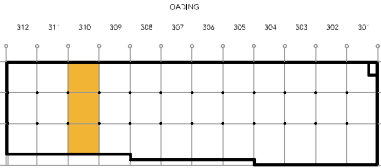

Key Plan

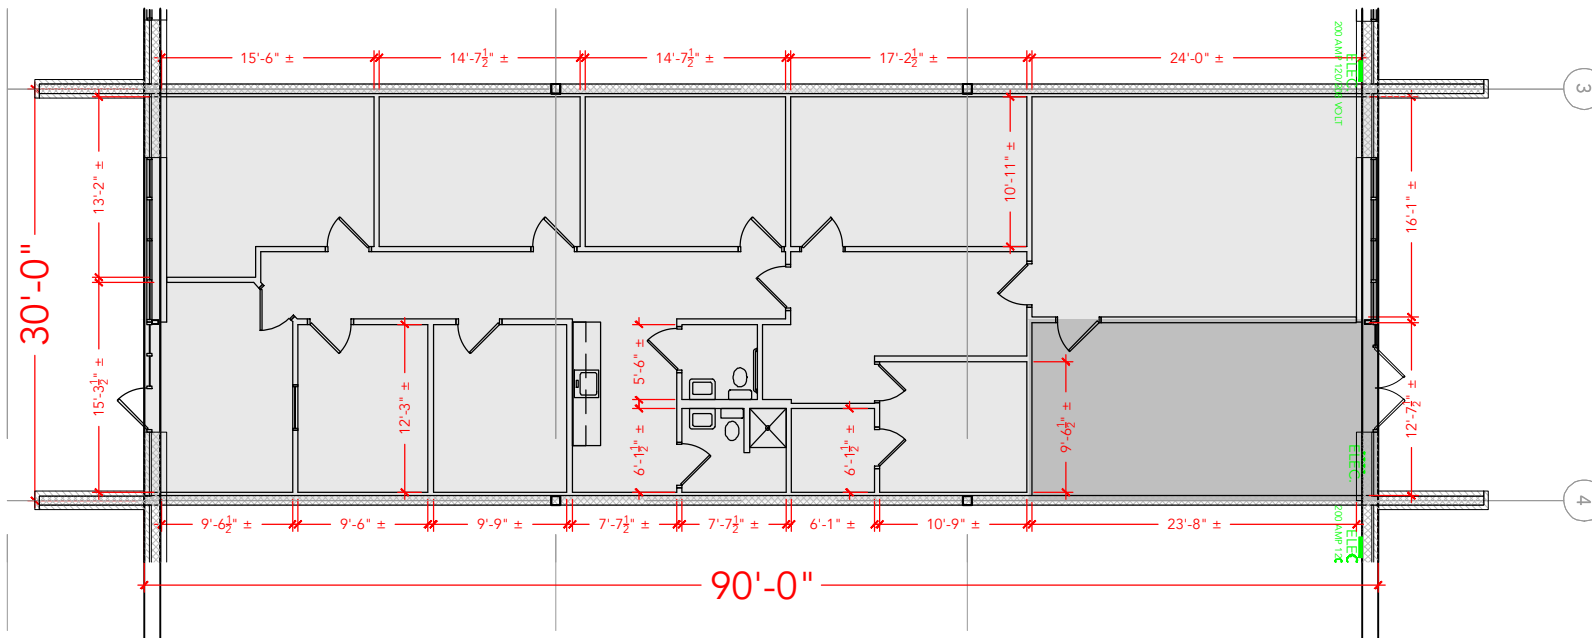

310

Floor Plan