

TOTAL SF AVAILABLE -6,300 SF


OFFICE - 1,450 SF

WAREHOUSE SF - 4,865 SF

[Click to access 3D model](#)



Key Plan

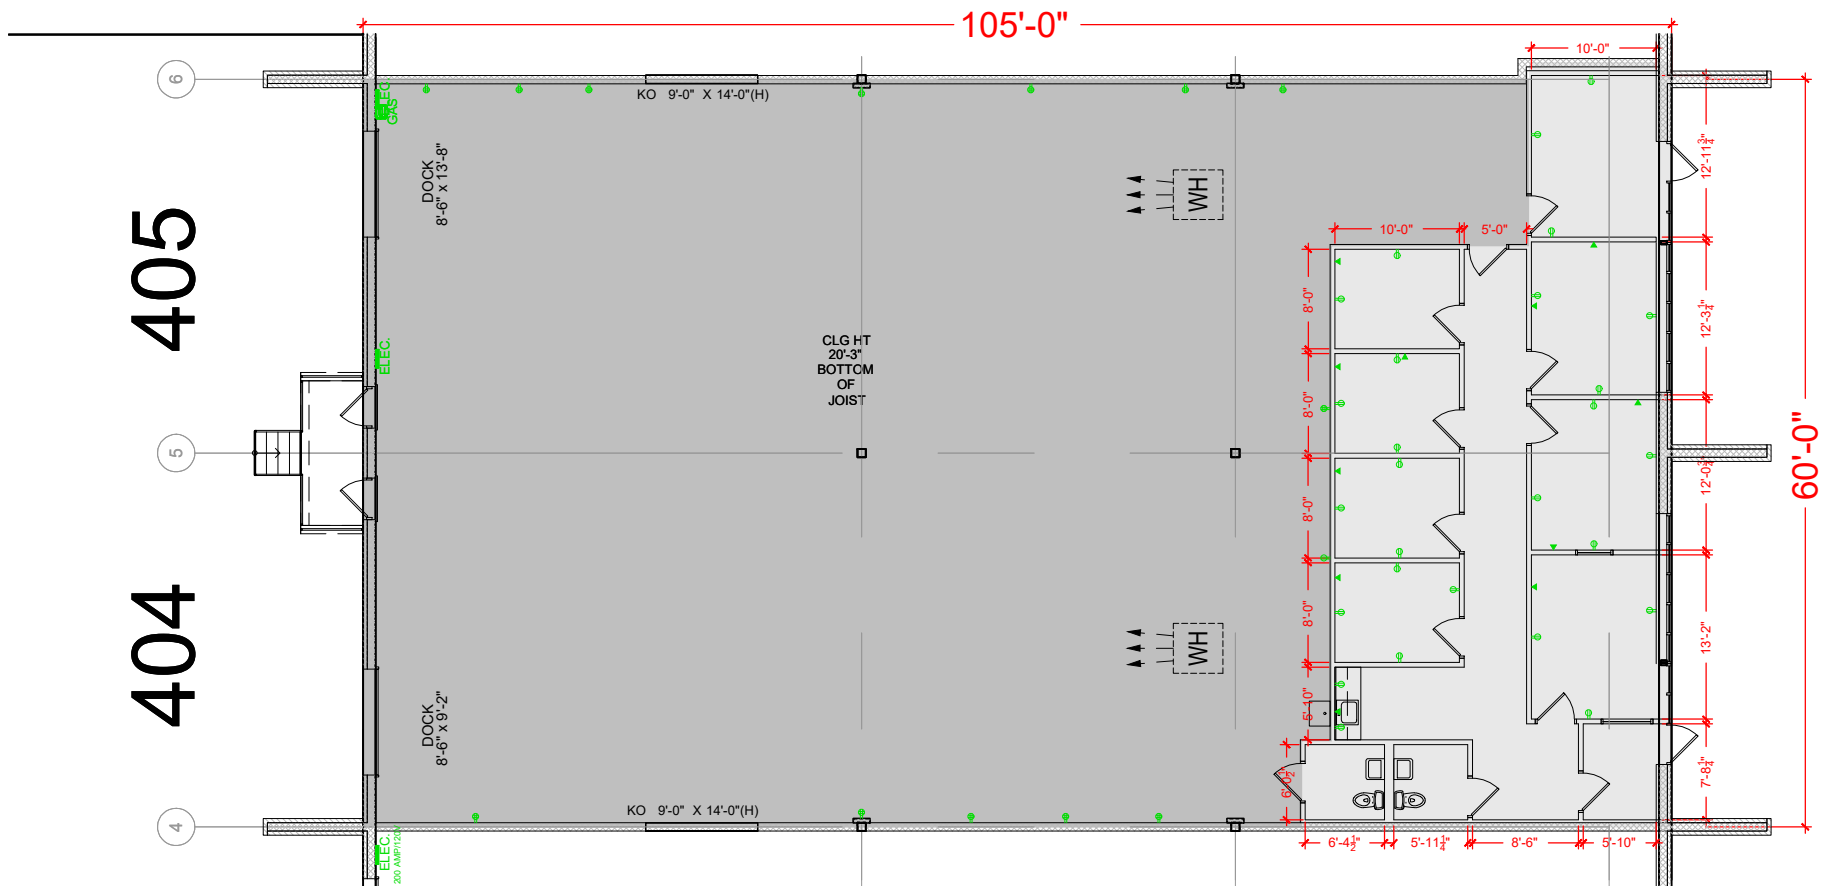

Floor Plan