



TOTAL SF AVAILABLE -6,300 SF

OFFICE - 1,435 SF
WAREHOUSE - 4,865 SF

[Click to access CADD file](#)

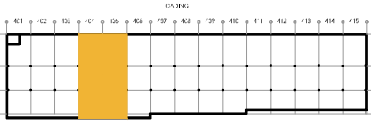

Key Plan

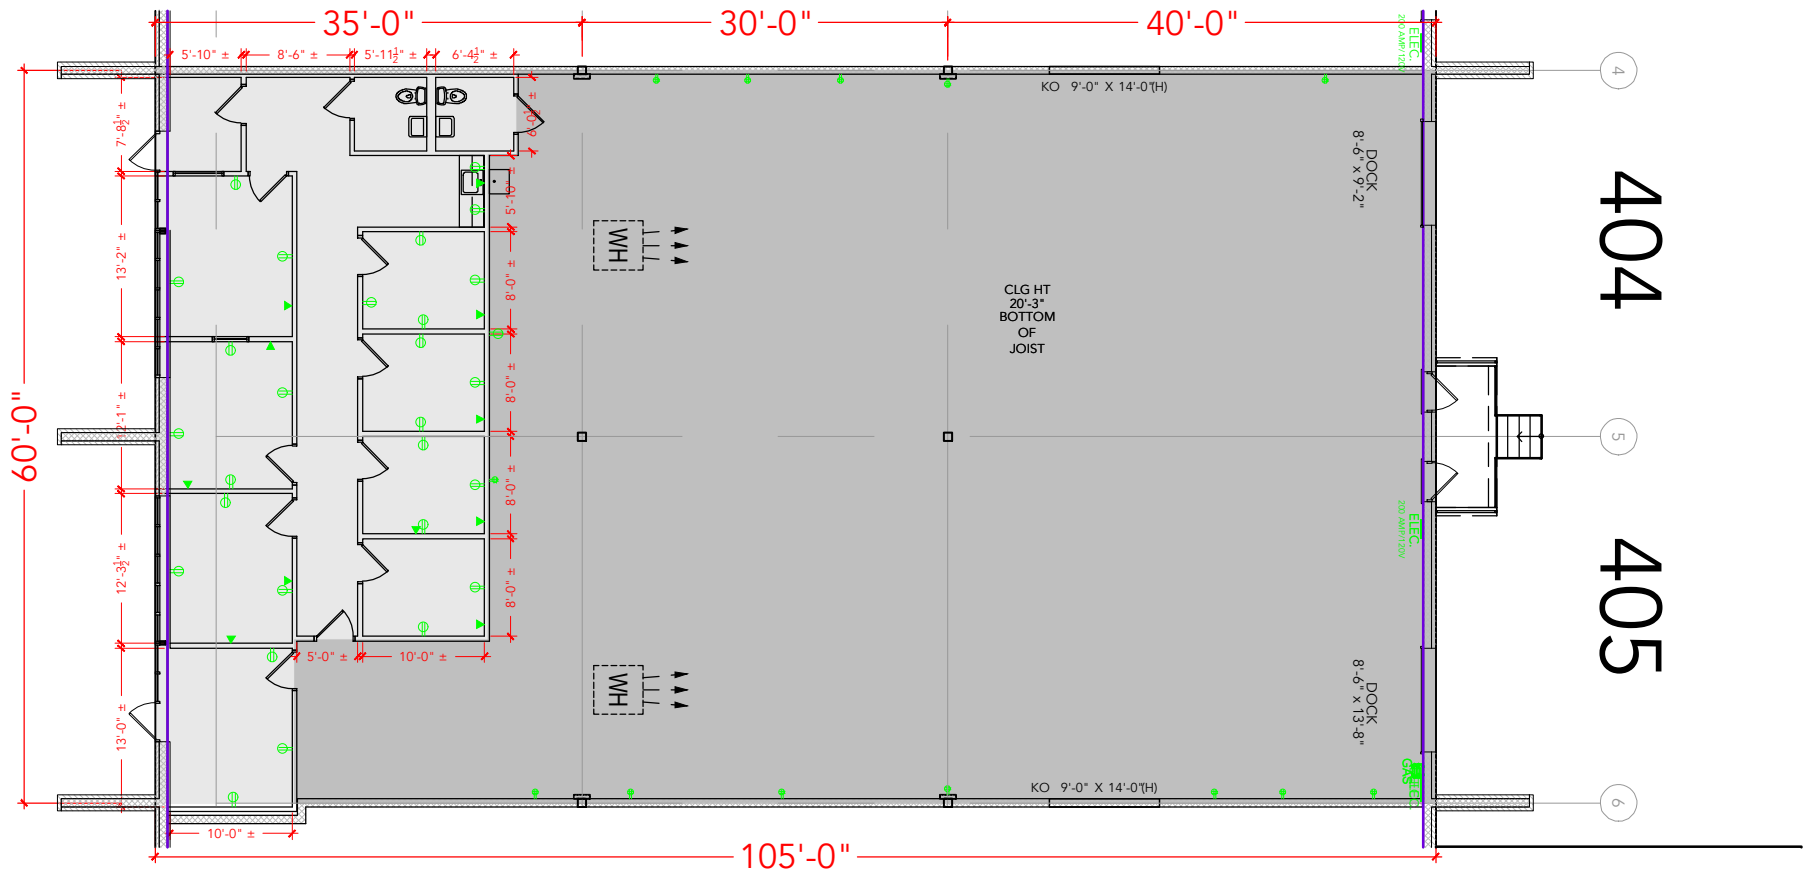

Floor Plan