


**TOTAL SF AVAILABLE -9,000 SF**


OFFICE - 3,943 SF

WAREHOUSE SF - 5,057 SF

[Click to access 3D model](#)

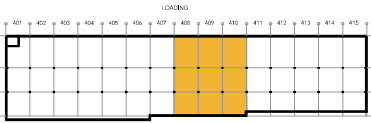

Key Plan

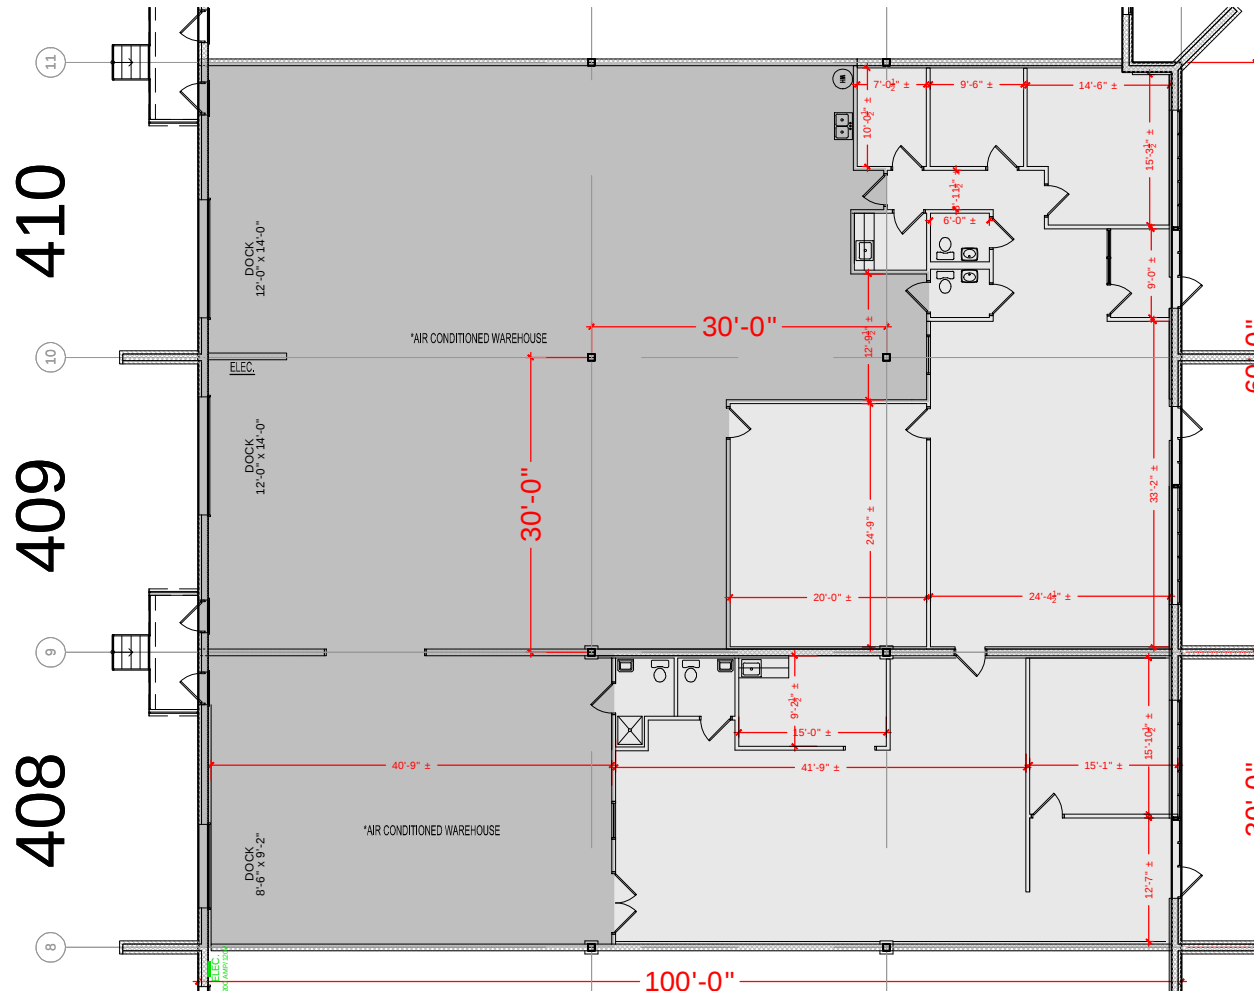

**ADING**  
Floor Plan