


TOTAL SF AVAILABLE - 93,600 SF
OFFICE - 0,000 SF
WAREHOUSE - 93,600 SF

[Click to access 3D model](#)

Key Plan

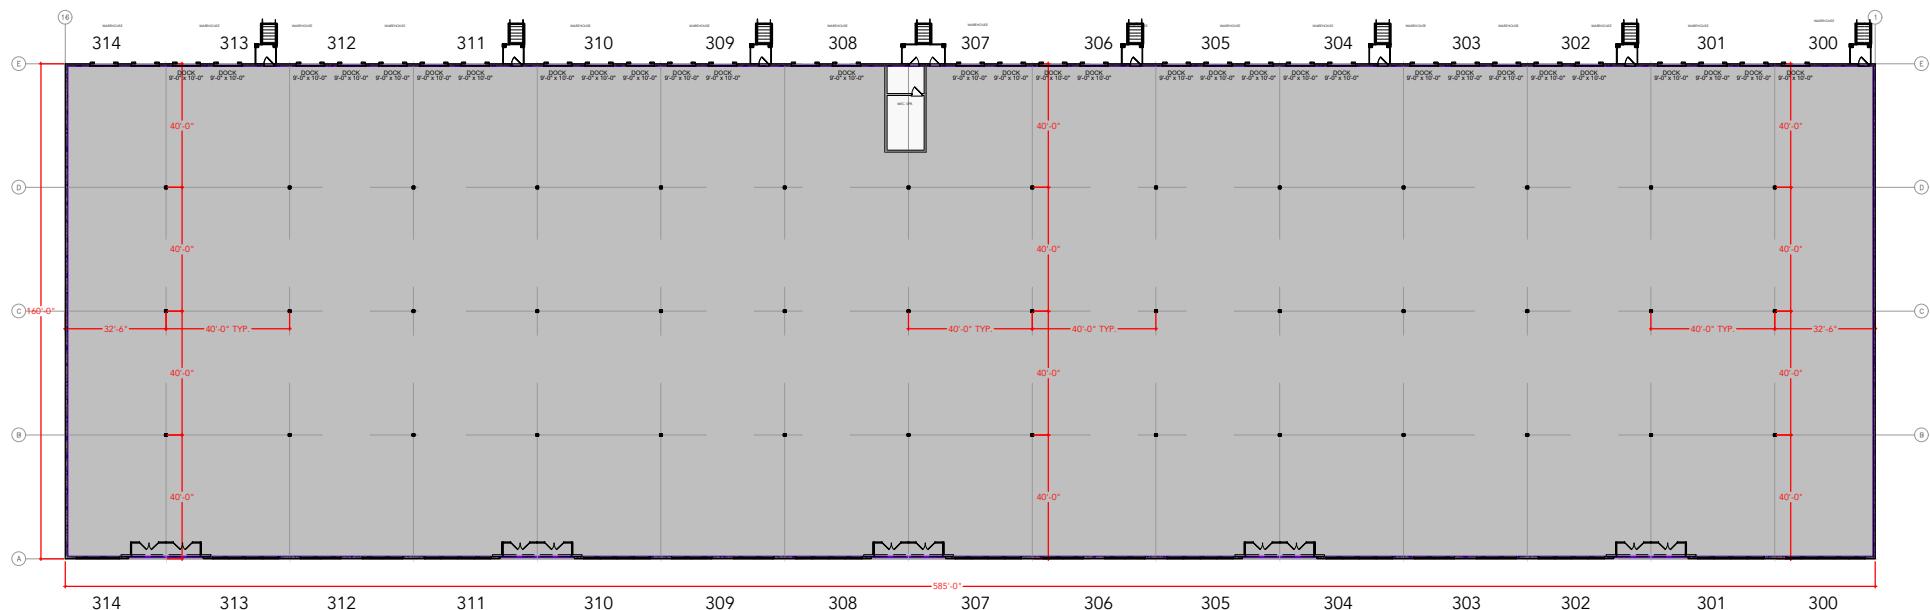

Floor Plan