

TOTAL SF AVAILABLE -60,900 RSF


OFFICE - 0,0000 RSF

WAREHOUSE - 60,900 RSF

* INCLUDES % OF METER ROOM

[Click to access CADD file](#)

Key Plan

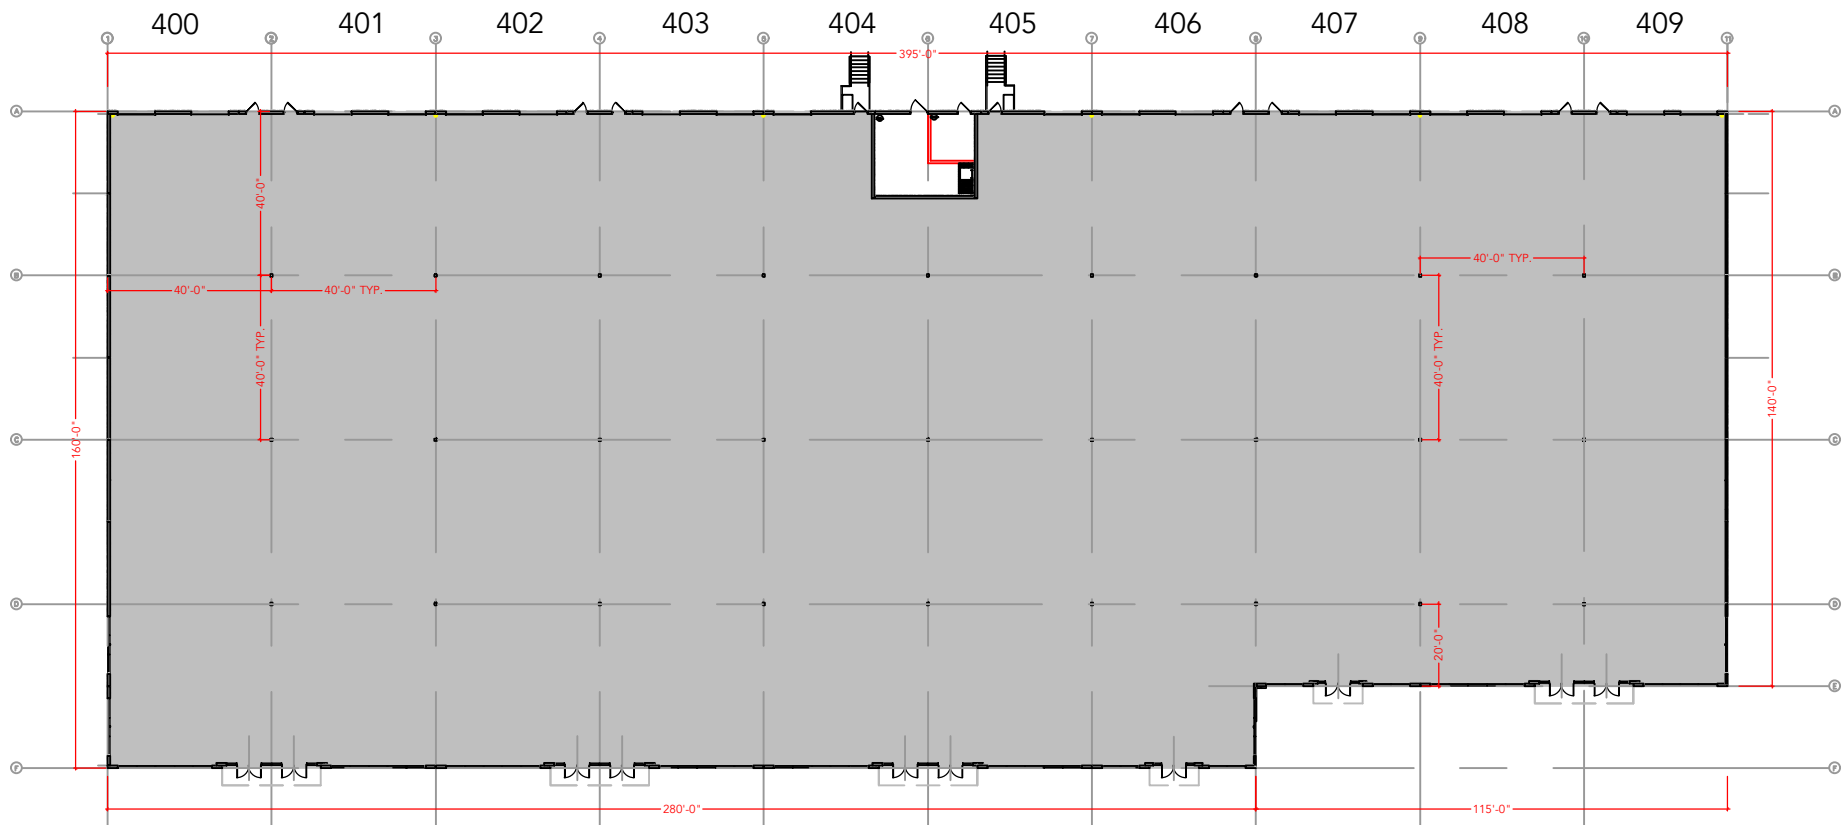

Floor Plan