


TOTAL SF AVAILABLE -99,000 RSF

OFFICE - 0,000 SF


WAREHOUSE - 99,000 RSF

* % OF MECH ROOM INCLUDED IN RSF

[Click to access CADD file](#)

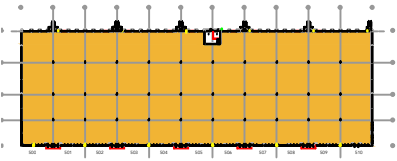

Key Plan

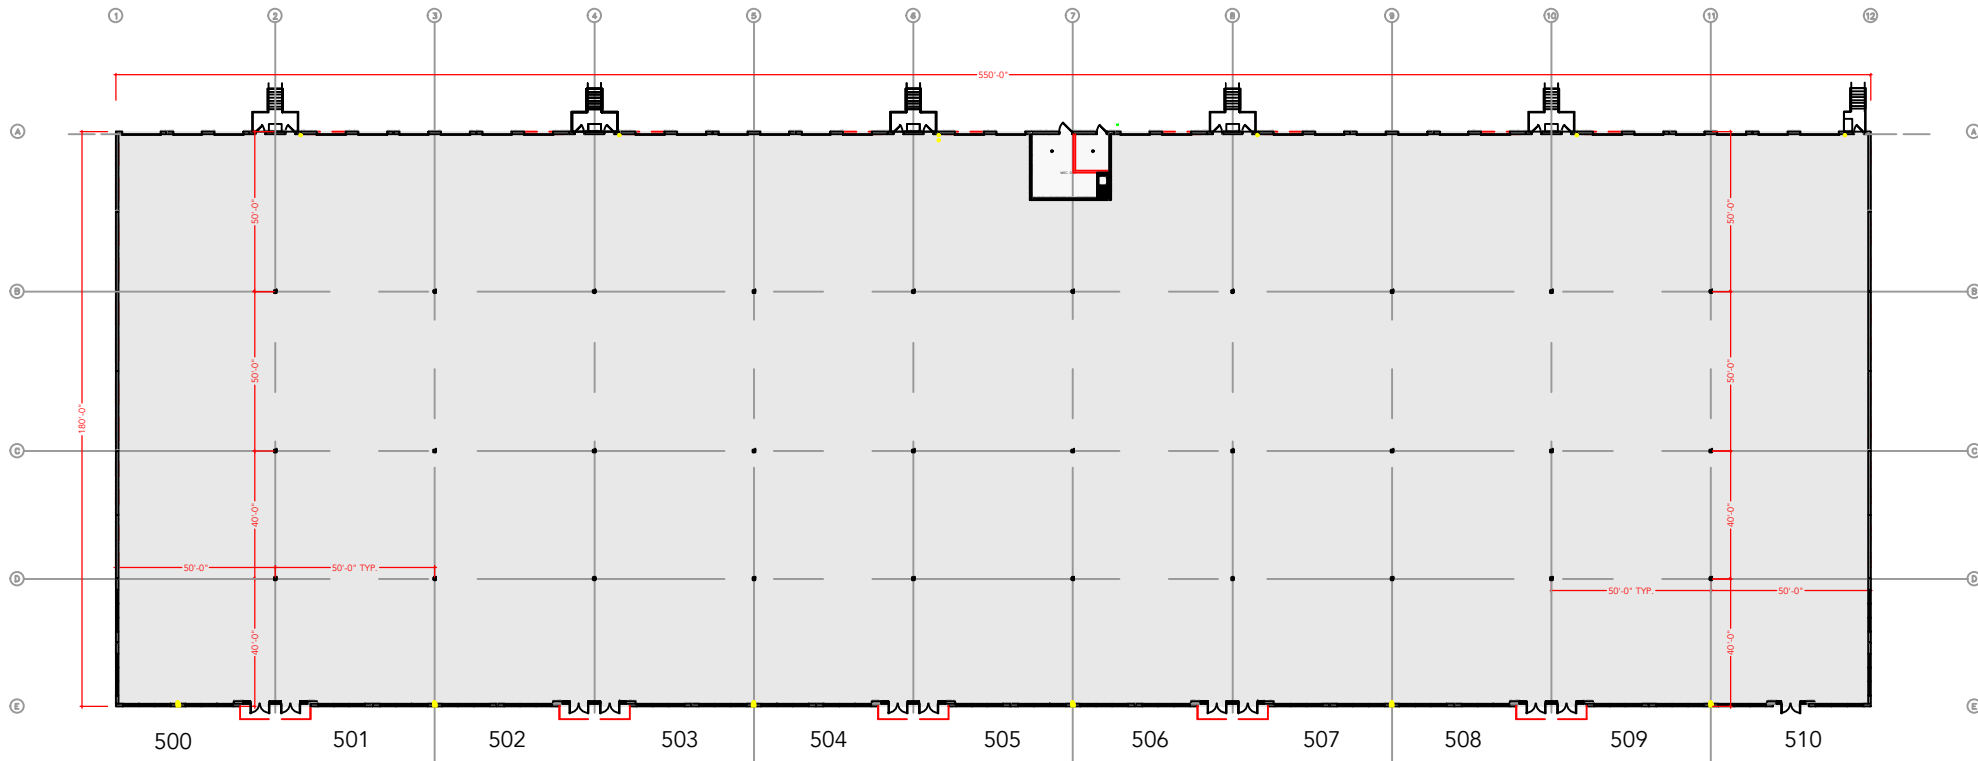

Floor Plan