



TOTAL SF AVAILABLE - 3,507 RSF (12%)

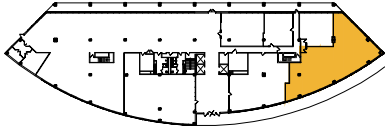

[Click to access 3D model](#)

Key Plan

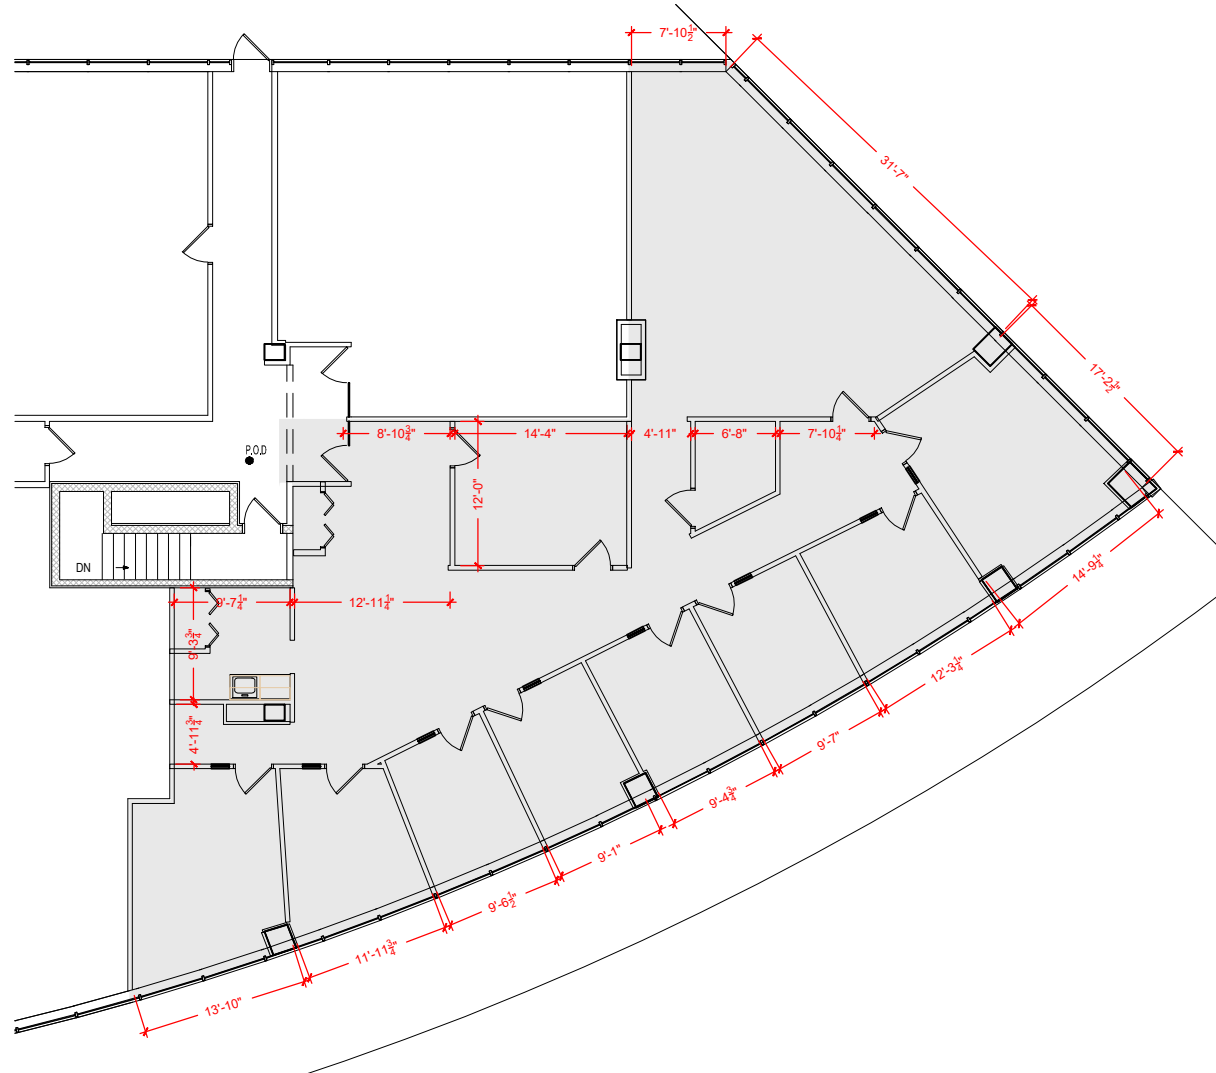

Floor Plan