



TOTAL SF AVAILABLE -2,209 RSF (16%)

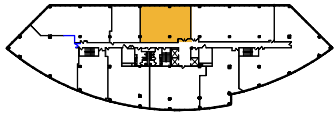

[Click to access 3D model](#)

Key Plan

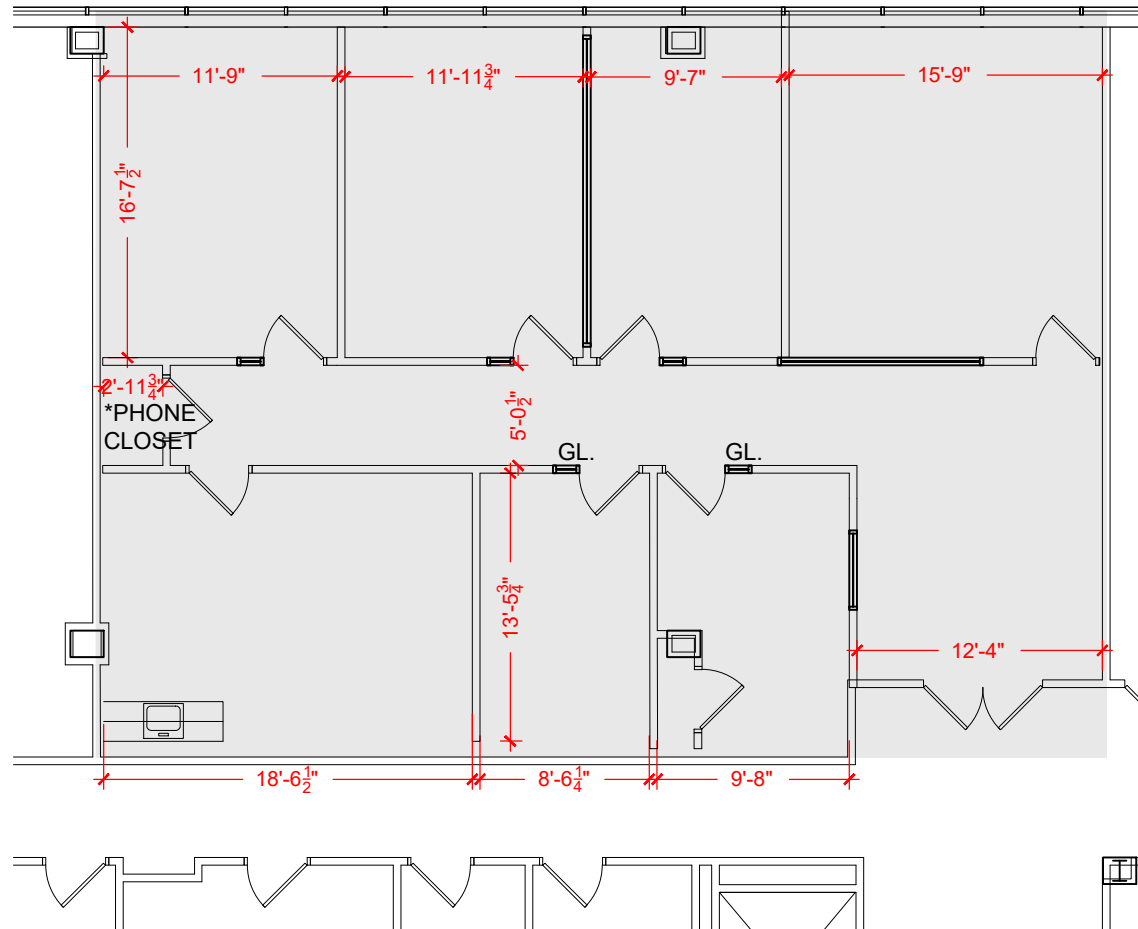

Floor Plan