



TOTAL SF AVAILABLE - 2,193 RSF (12%)

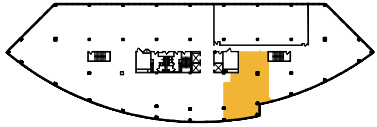

[Click to access 3D model](#)

Key Plan

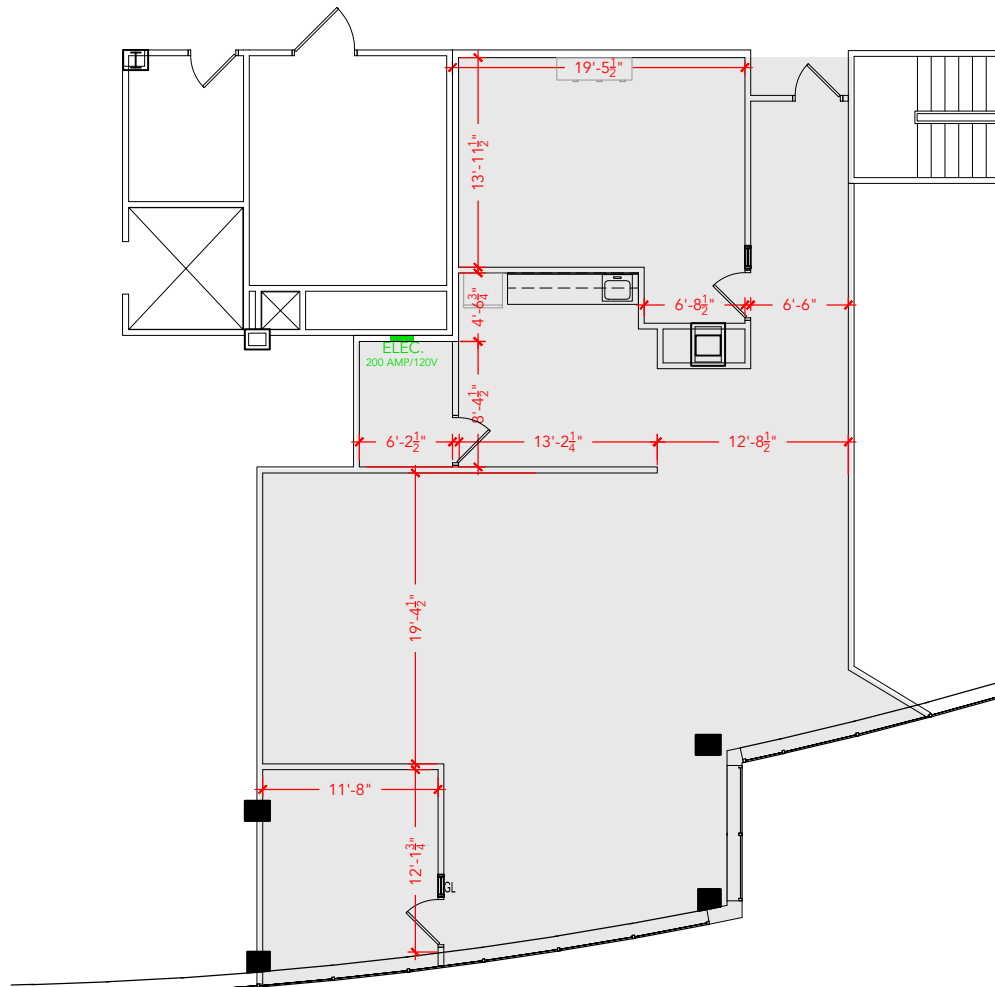

Floor Plan