



TOTAL SF AVAILABLE - 10,774 RSF(12%)

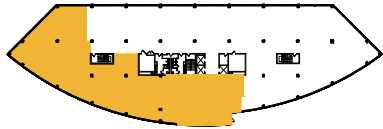

[Click to access 3D model](#)

## Key Plan

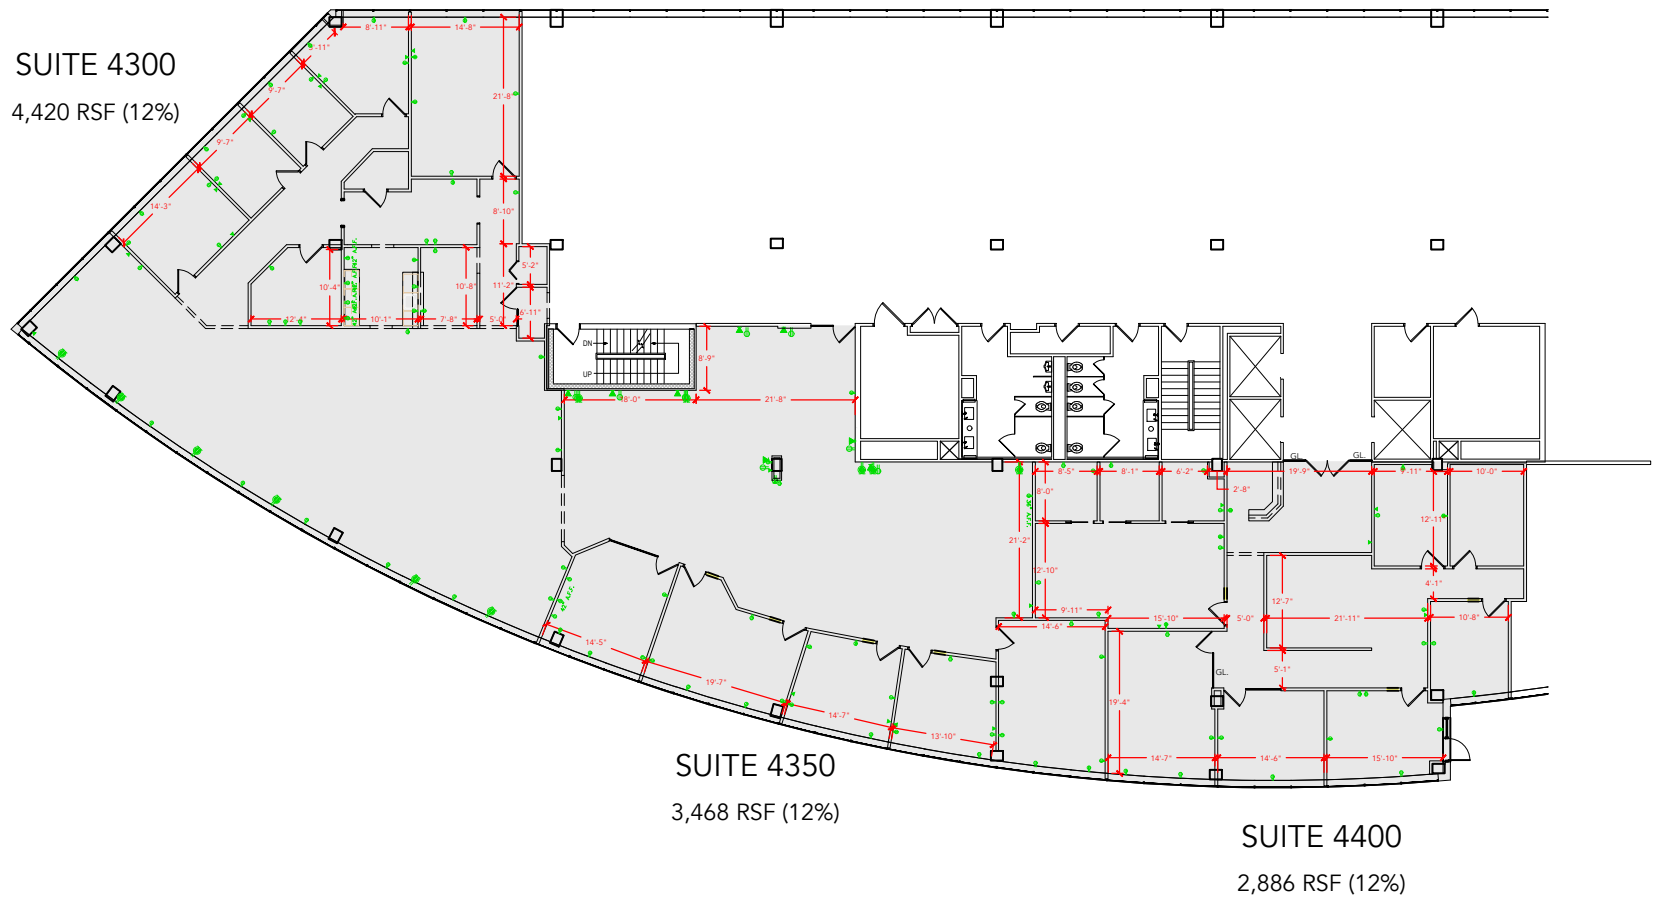

## Floor Plan