


TOTAL SF AVAILABLE - 11,105 RSF(16%)



Key Plan

[Click to access CADD file](#)

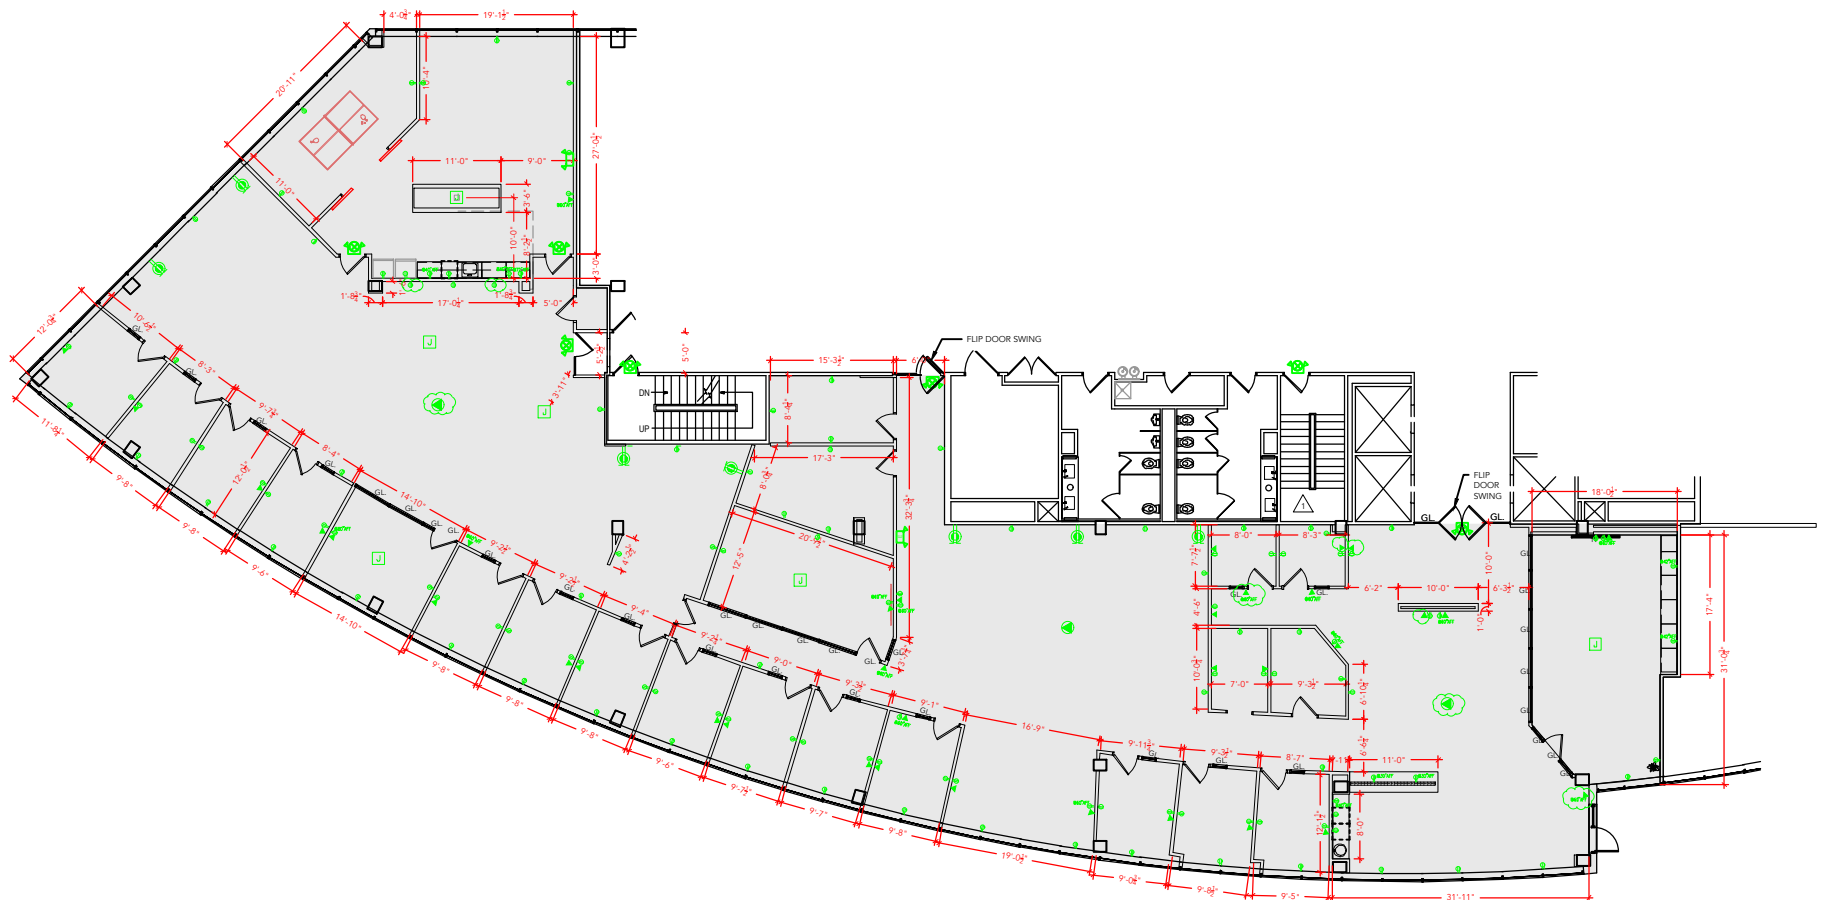

Floor Plan