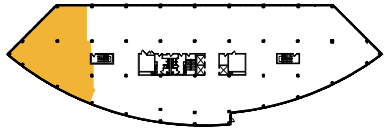
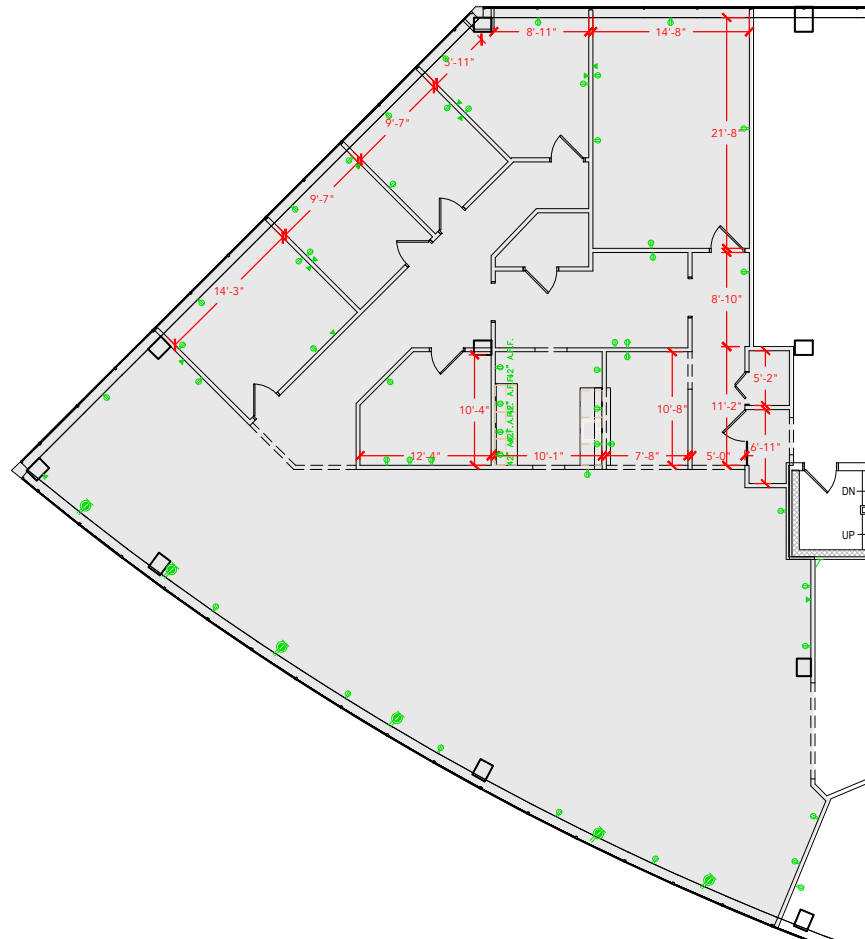


TOTAL SF AVAILABLE - 4,420 RSF(12%)

Key Plan

[Click to access 3D model](#)

Floor Plan