



TOTAL SF AVAILABLE - 992 RSF (16%)

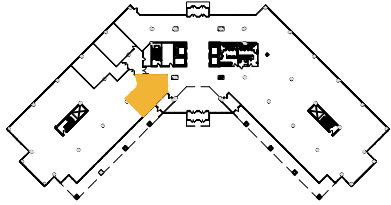

Key Plan

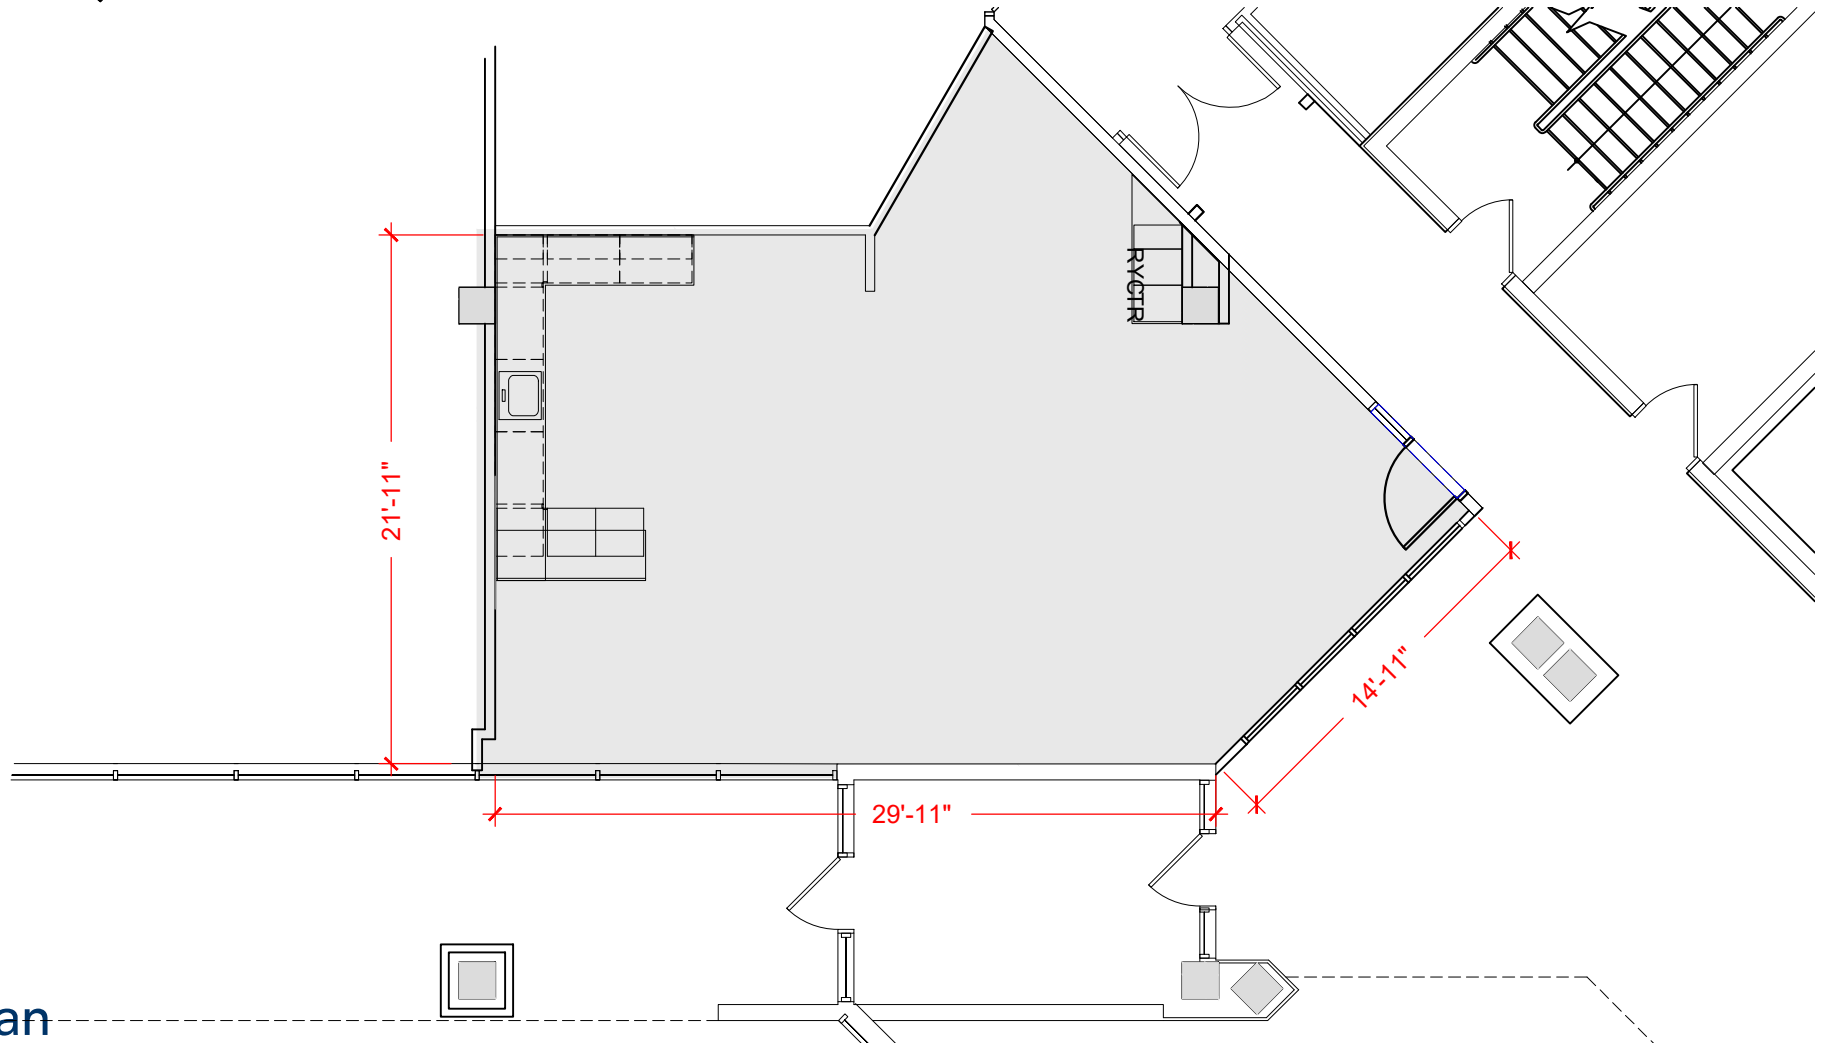

Floor Plan