



TOTAL SF AVAILABLE - 1,096 RSF(16%)

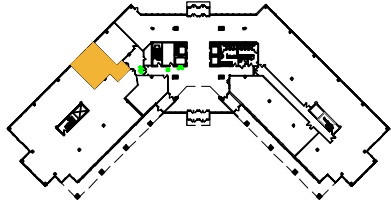

Key Plan

[Click to access CADD file](#)

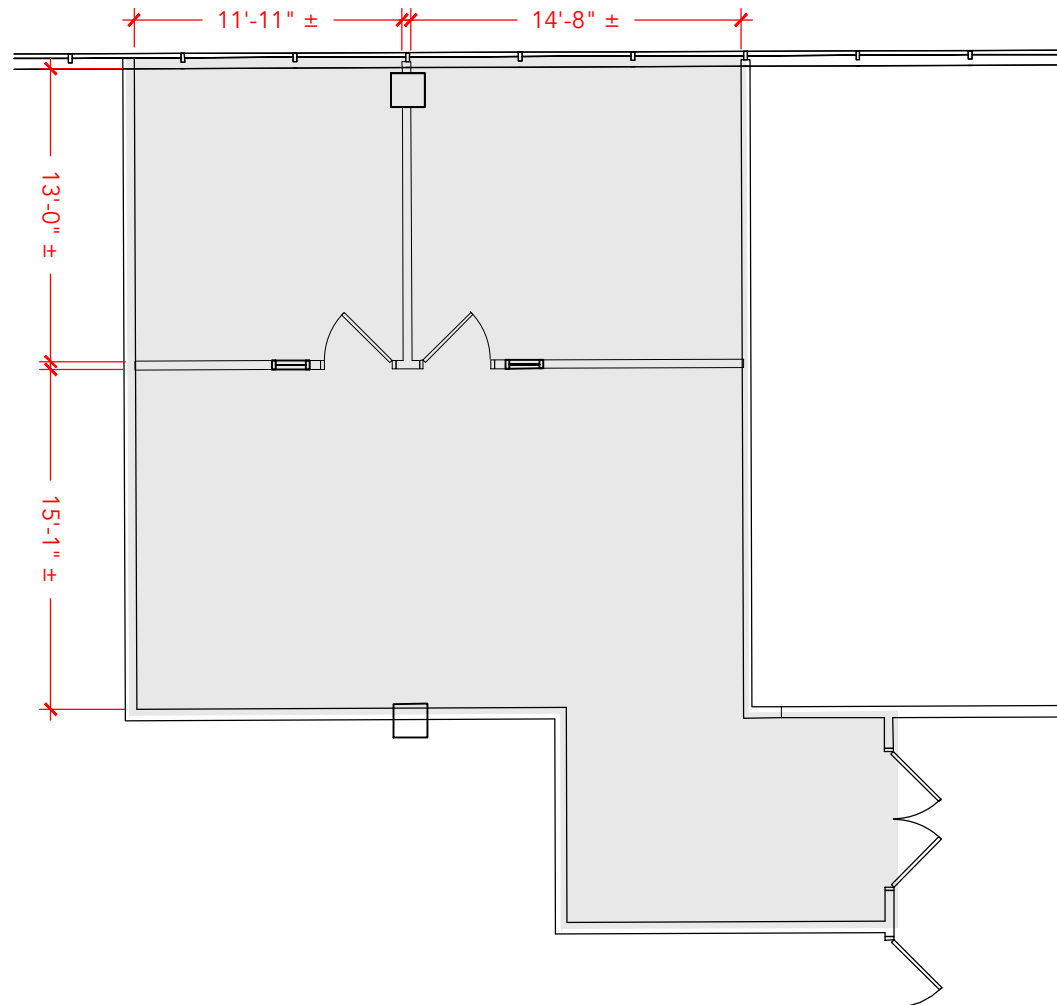

Floor Plan