



TOTAL SF AVAILABLE -8,983 RSF(16%)

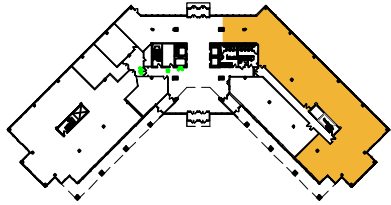

Key Plan

[Click to access CADD file](#)

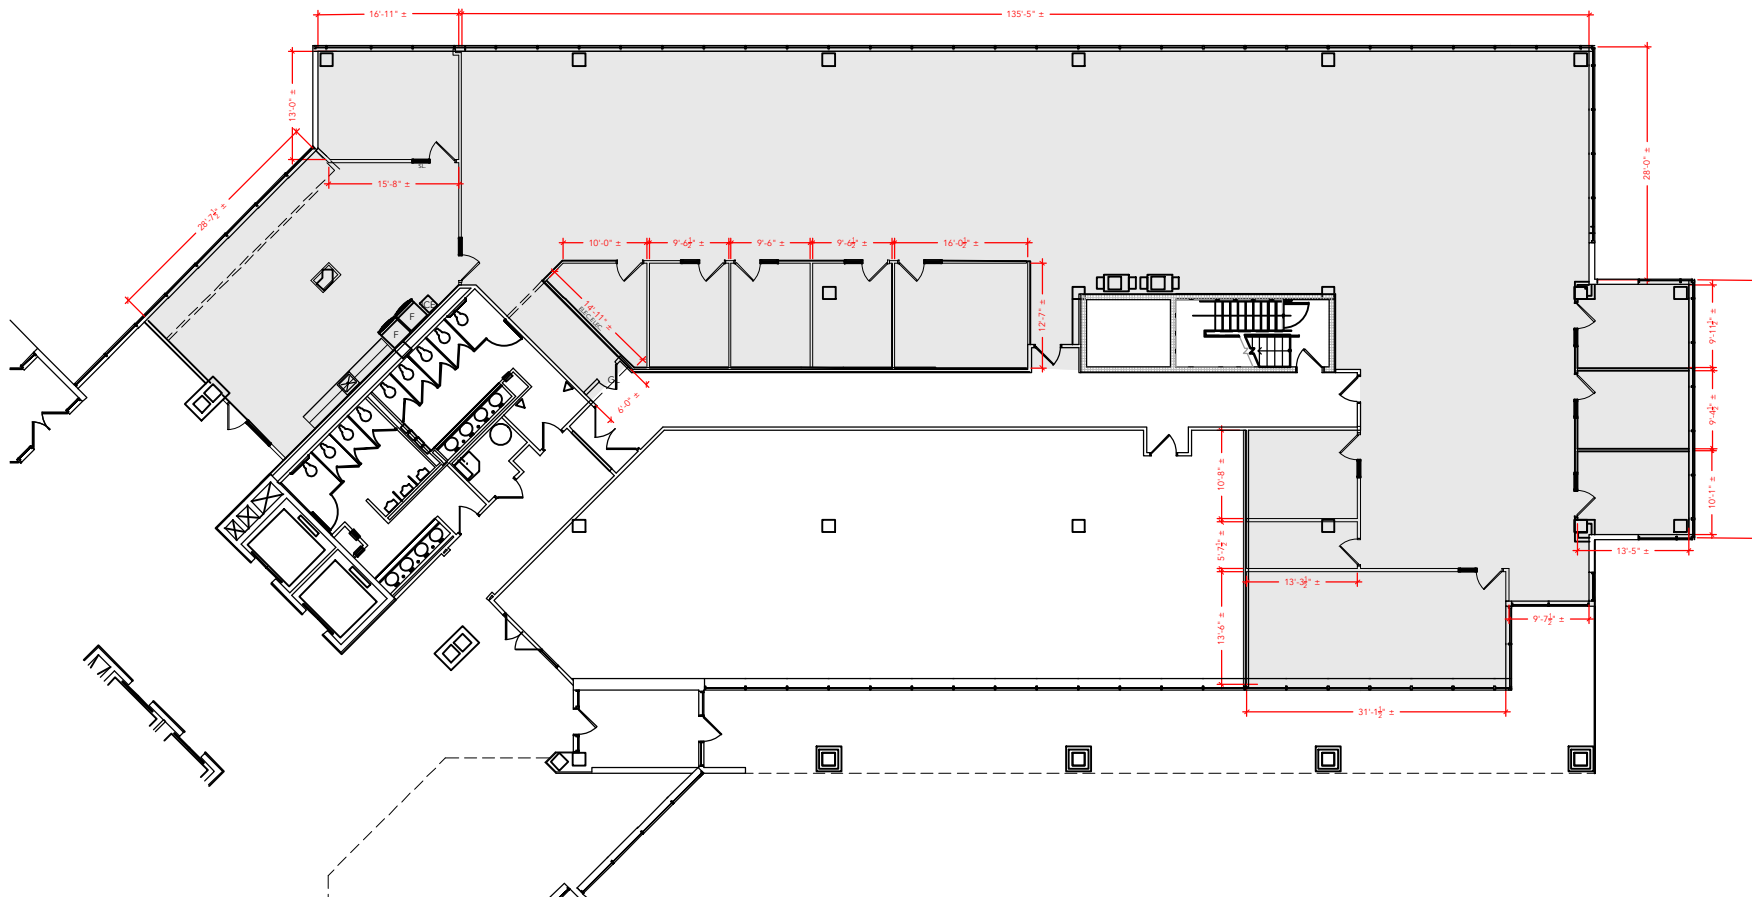

Floor Plan