
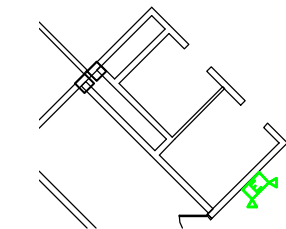


TOTAL SF AVAILABLE -12,658 RSF(16%)

[Click to access CADD file](#)

Key Plan

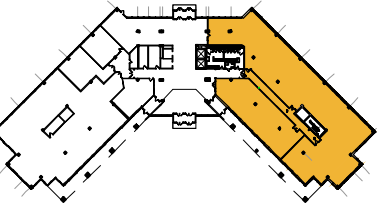

Floor Plan

SUITE 160-180  
8,983 RSF(16%)

CORRIDOR 752 RSF(16%)

SUITE 190  
2,923 RSF(16%)

