



TOTAL SF AVAILABLE - 18,937 RSF(16%)

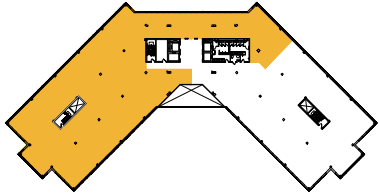

Key Plan

[Click to access 3D model](#)

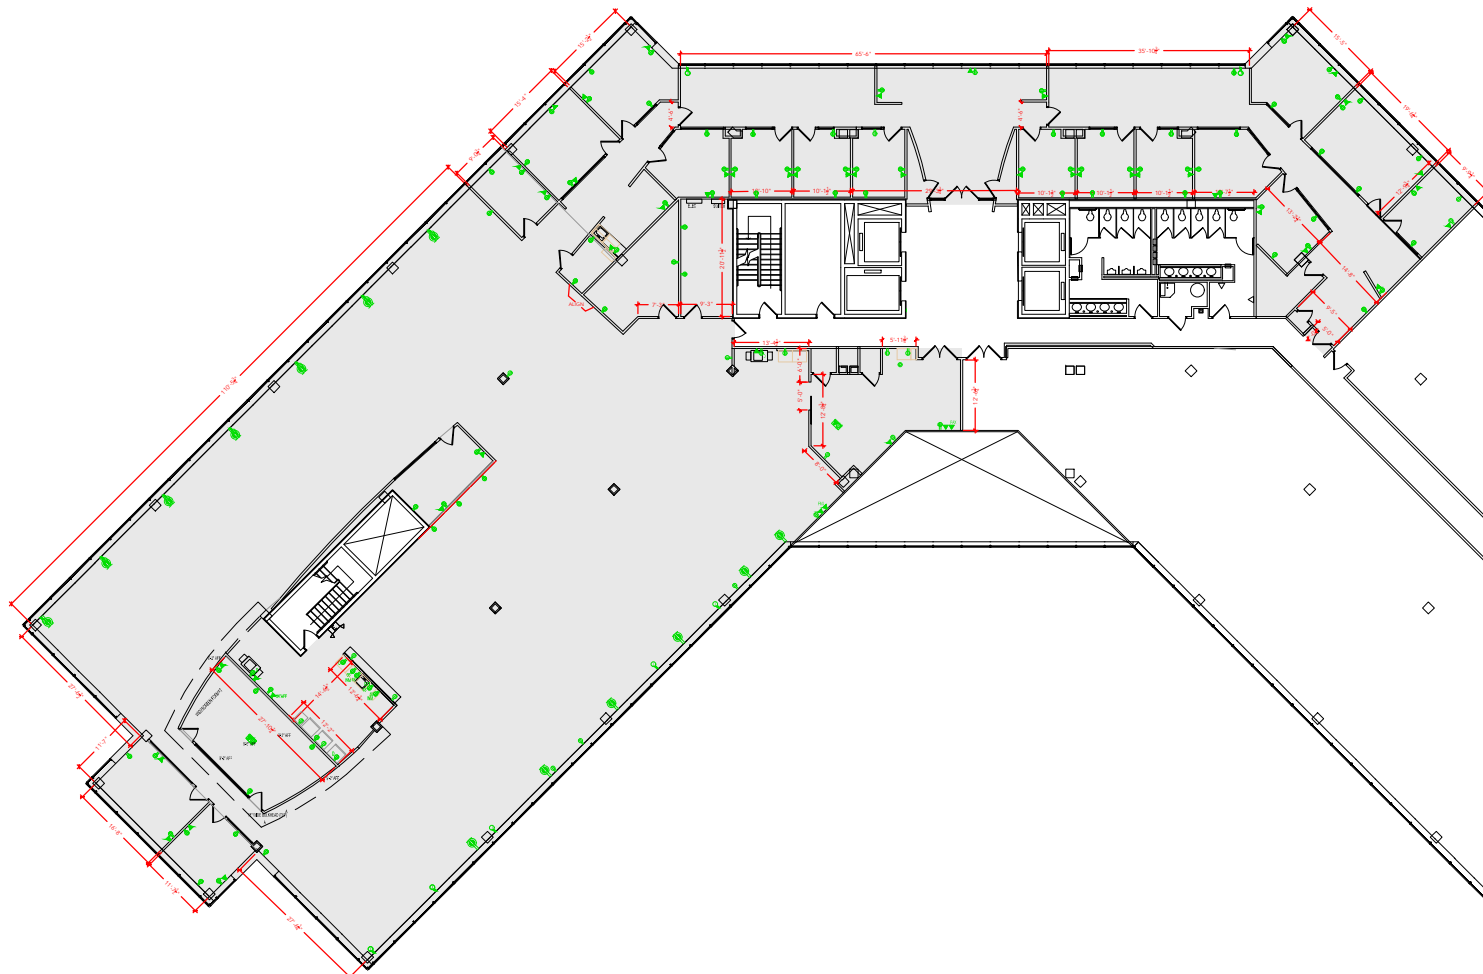

Floor Plan