



TOTAL SF AVAILABLE -7,644 RSF(16%)

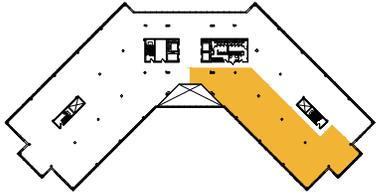

Key Plan

[Click to access 3D model](#)

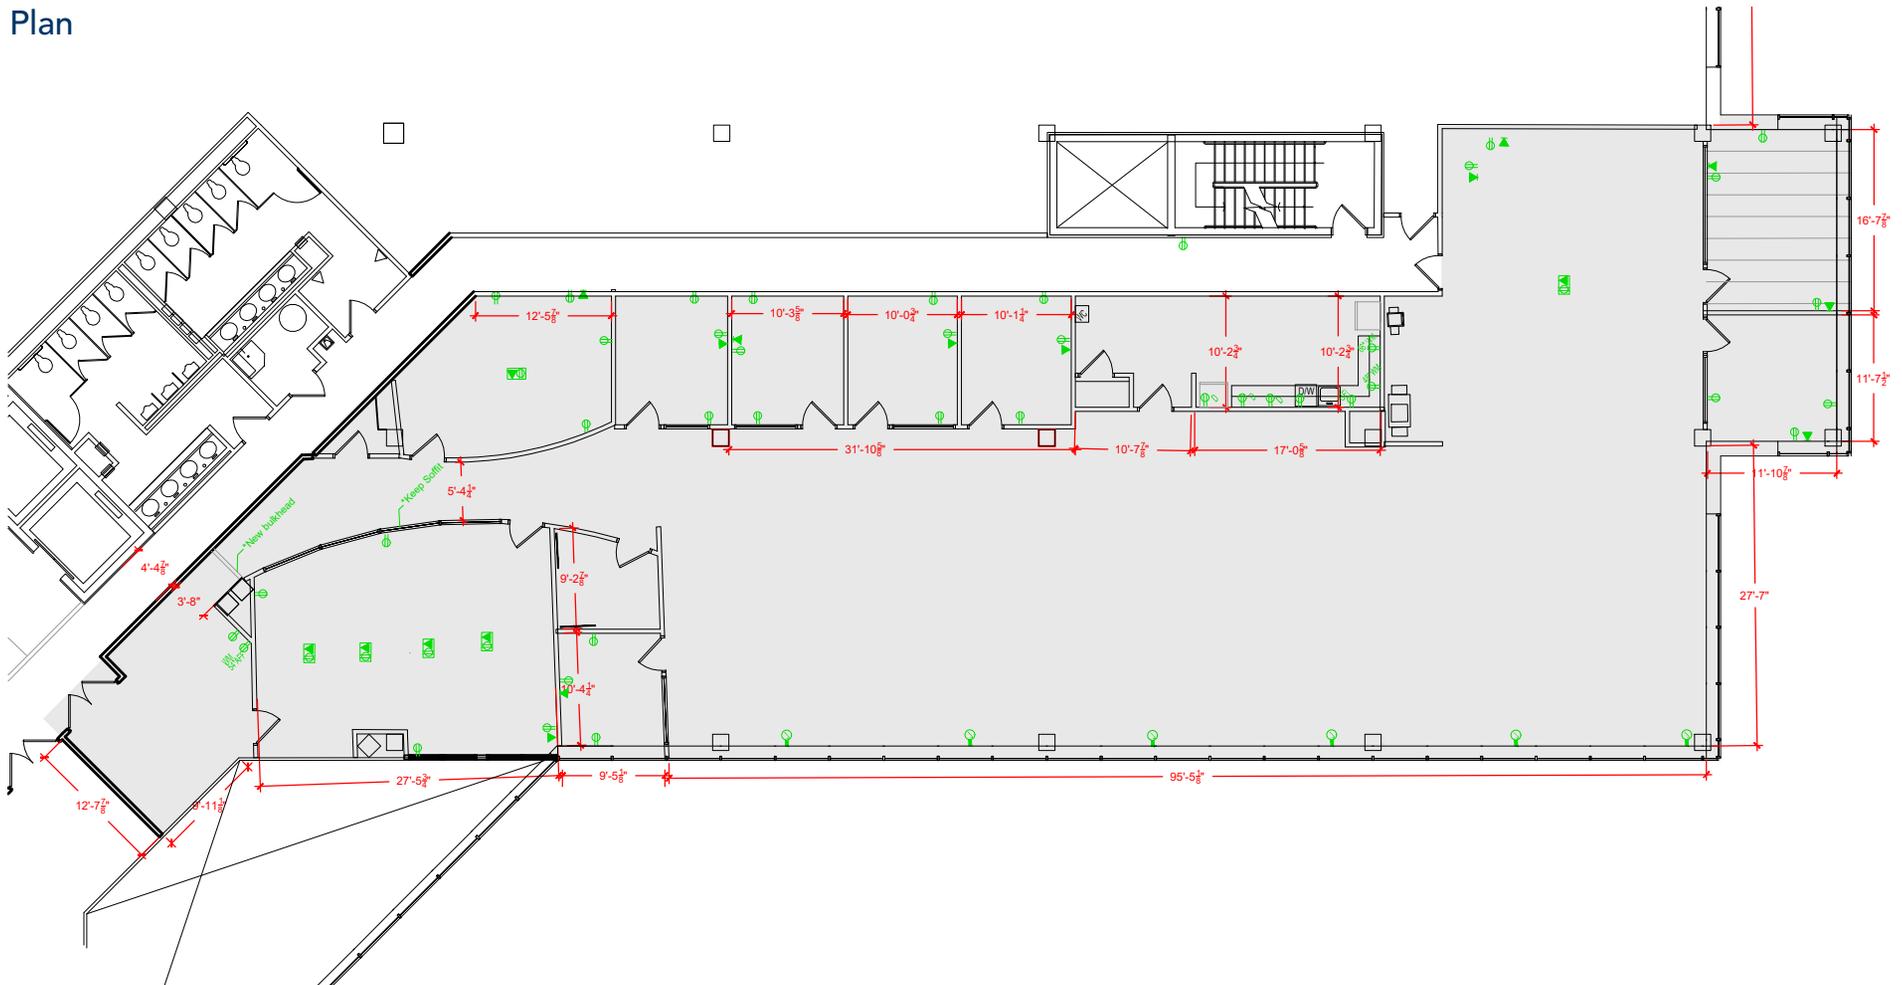

Floor Plan