



TOTAL SF AVAILABLE -2,676 RSF (16%)

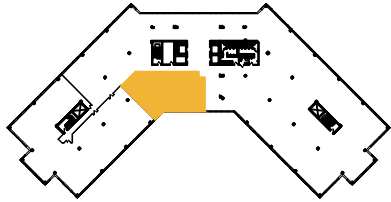

Key Plan

[Click to access 3D model](#)

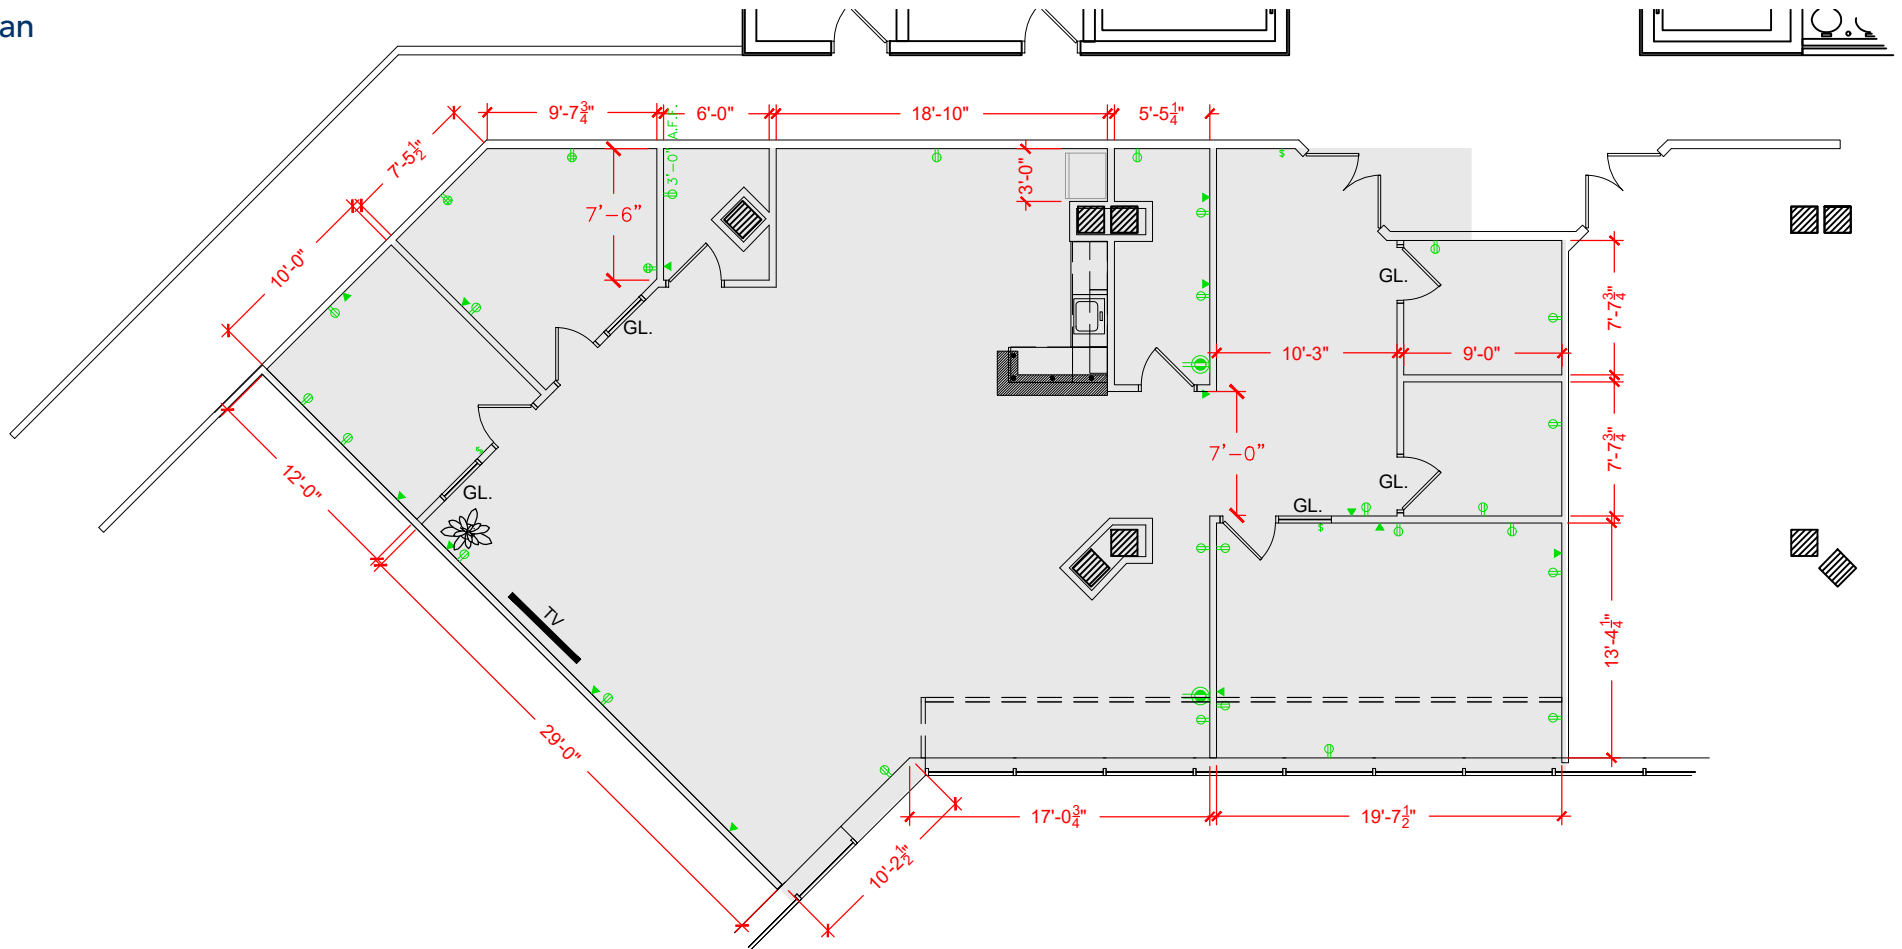

## Floor Plan