

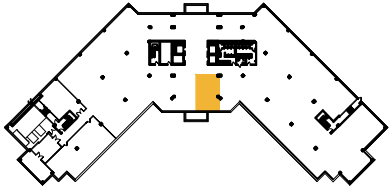
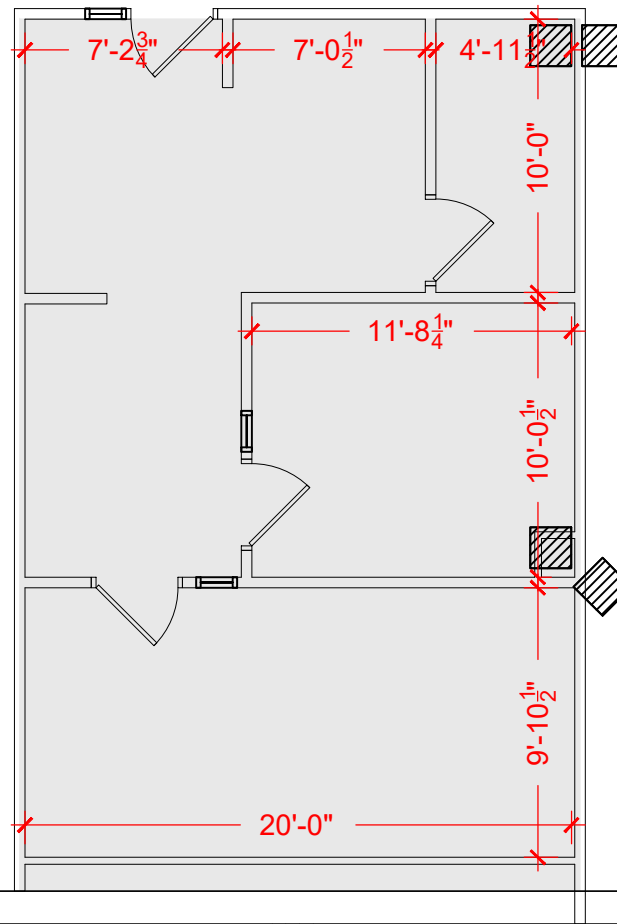


TOTAL SF AVAILABLE - 749 RSF (16%)

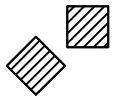

[Click to access 3D model](#)

Key Plan

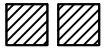

Floor Plan