



TOTAL SF AVAILABLE - 1,844 RSF (16%)

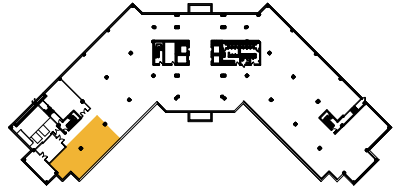

Key Plan

[Click to access 3D model](#)

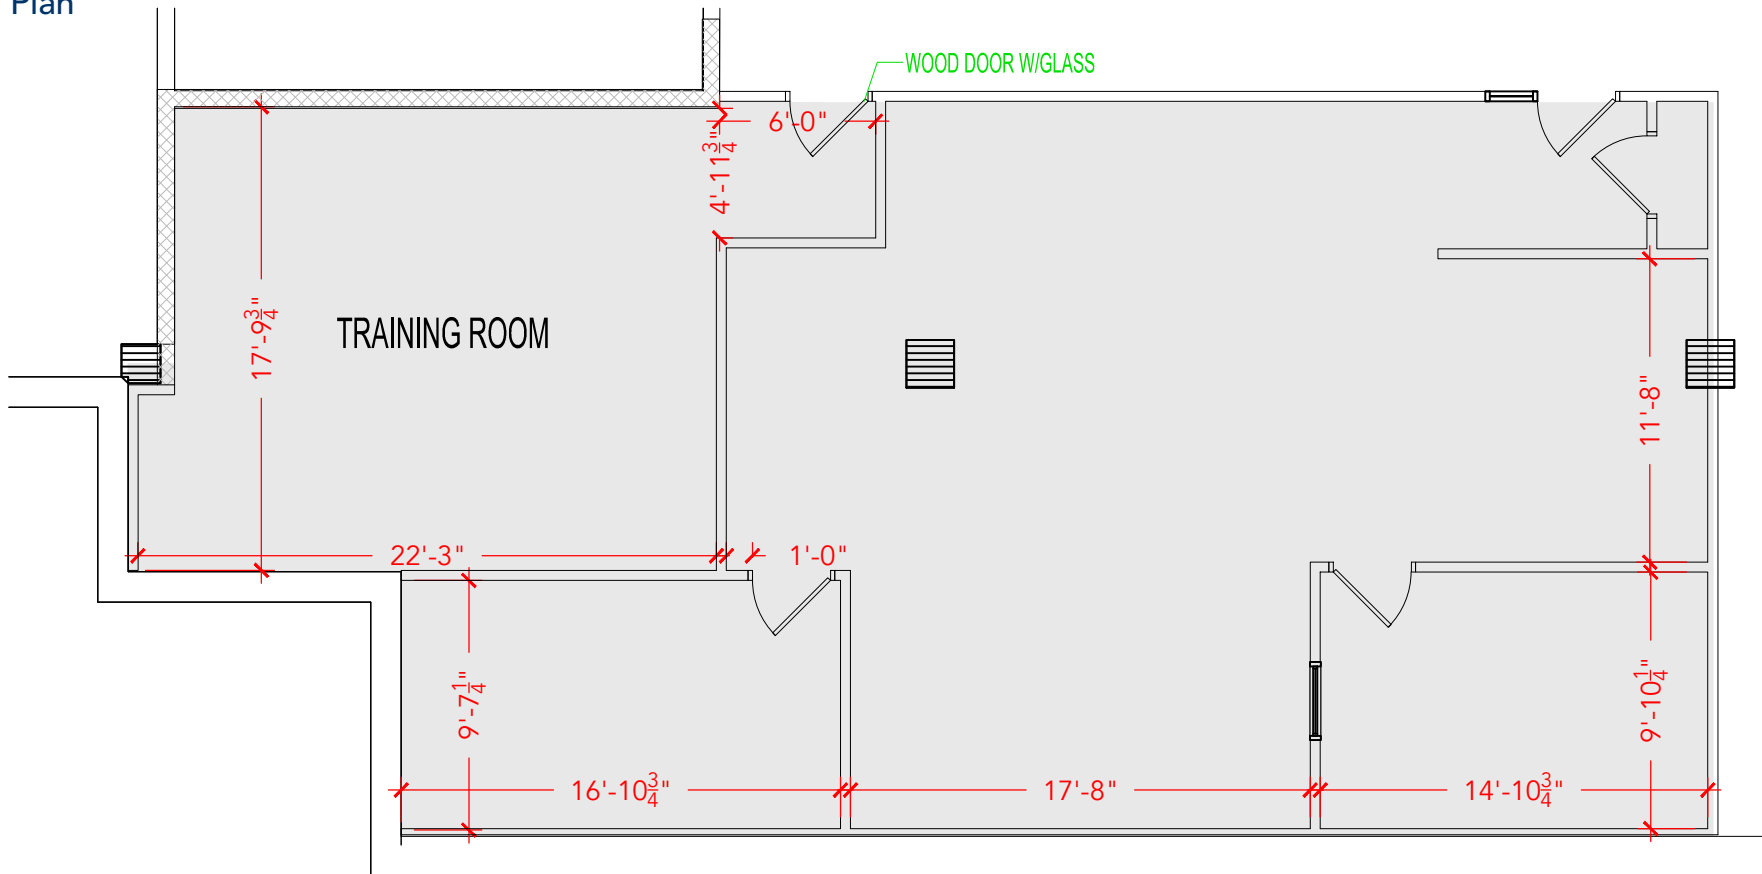

## Floor Plan