



TOTAL SF AVAILABLE -1,814 RSF(16%)

[Click to access CADD file](#)

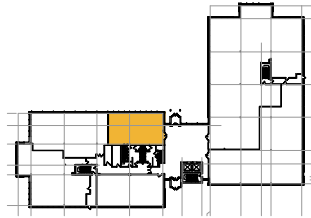

Key Plan

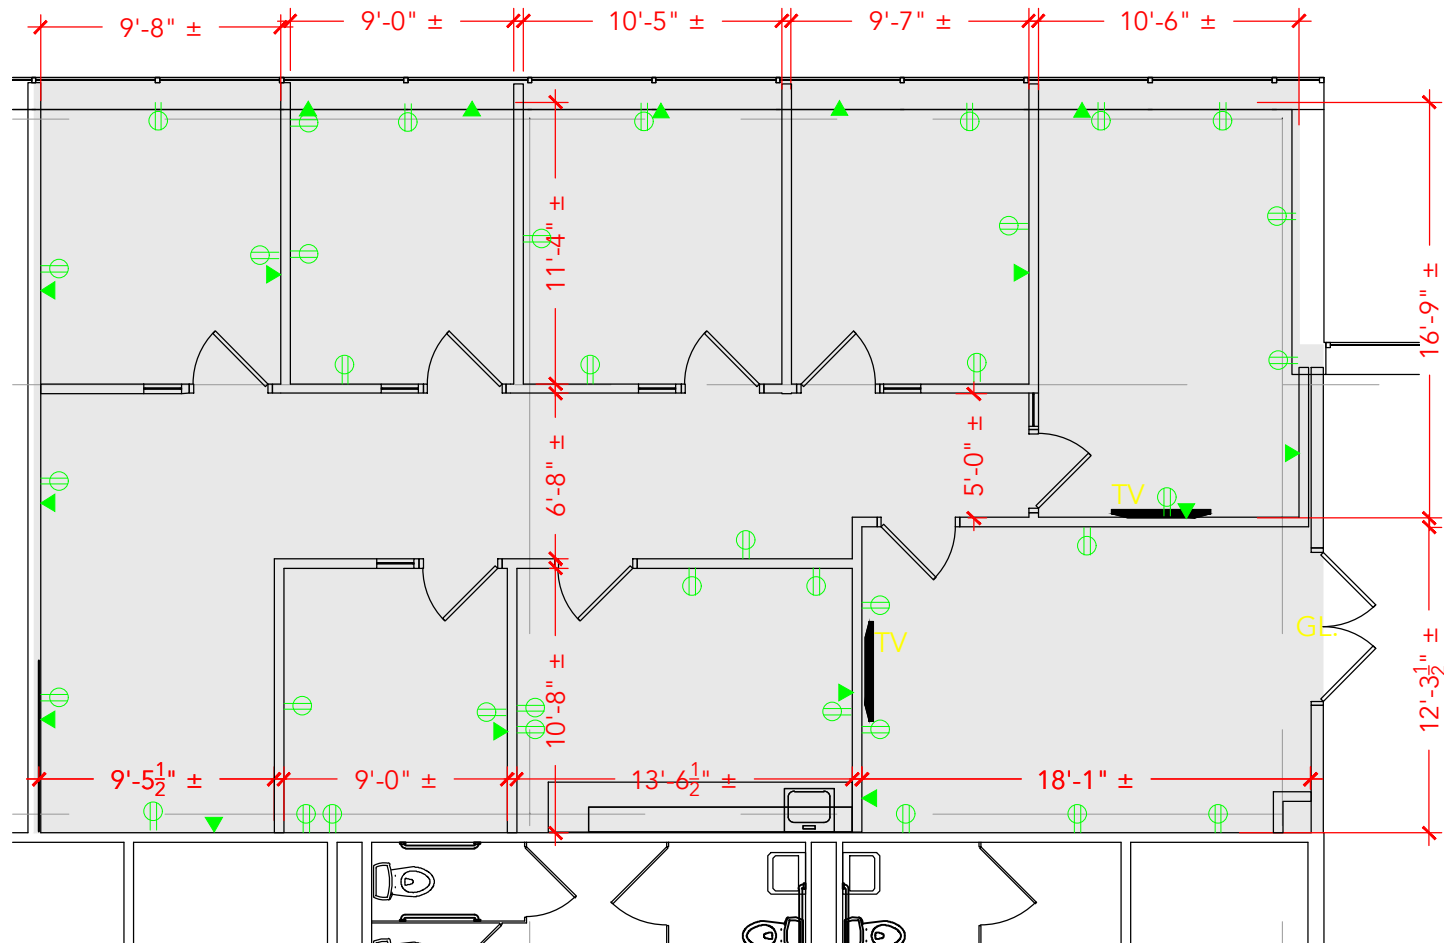

Floor Plan