


TOTAL SF AVAILABLE - 14,347 RSF(12%)

[Click to access 3D model](#)



Key Plan

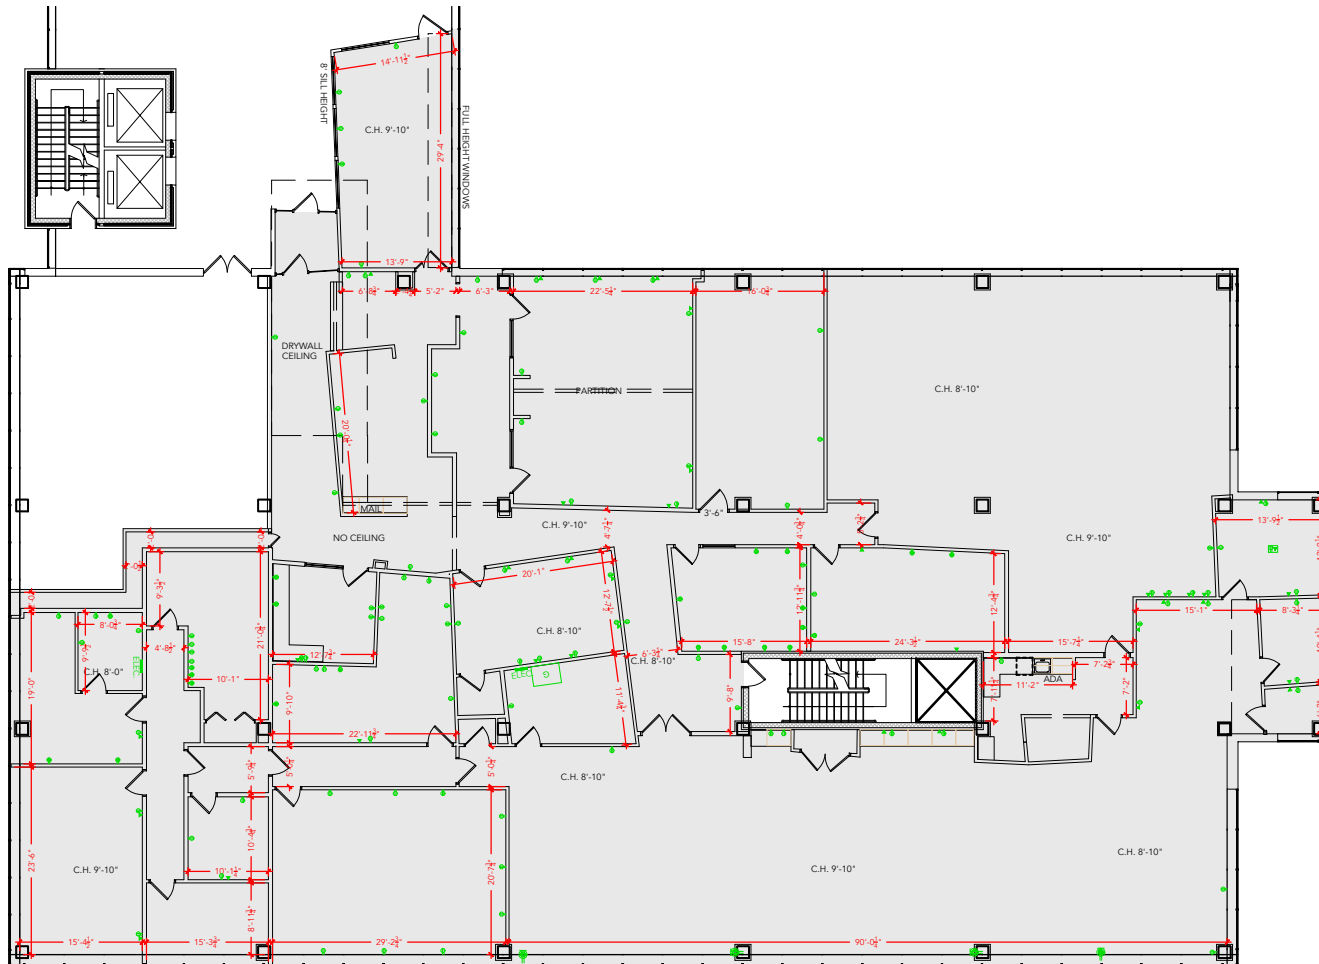

Floor Plan