
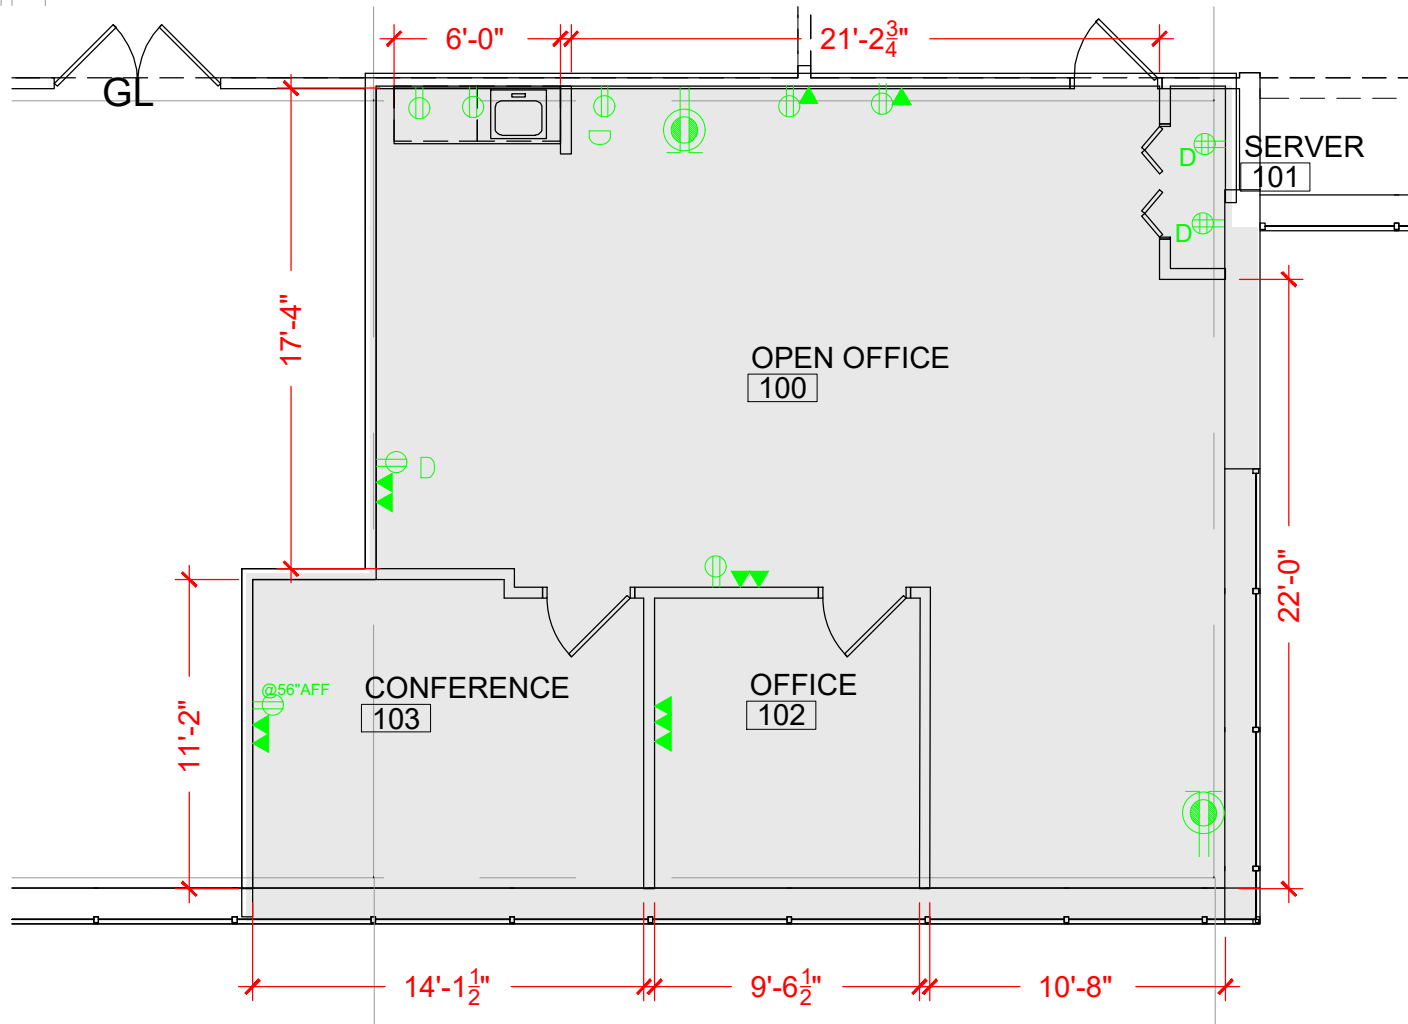


TOTAL SF AVAILABLE -1,176 RSF (16%)

[Click to access CADD file](#)

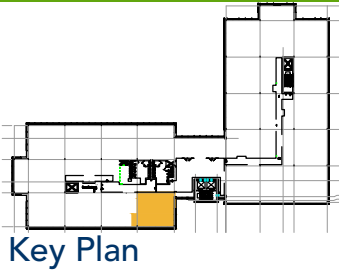

Floor Plan