



TOTAL SF AVAILABLE - 1,833 RSF(16%)

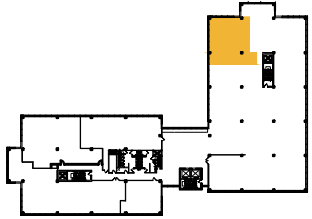

Key Plan

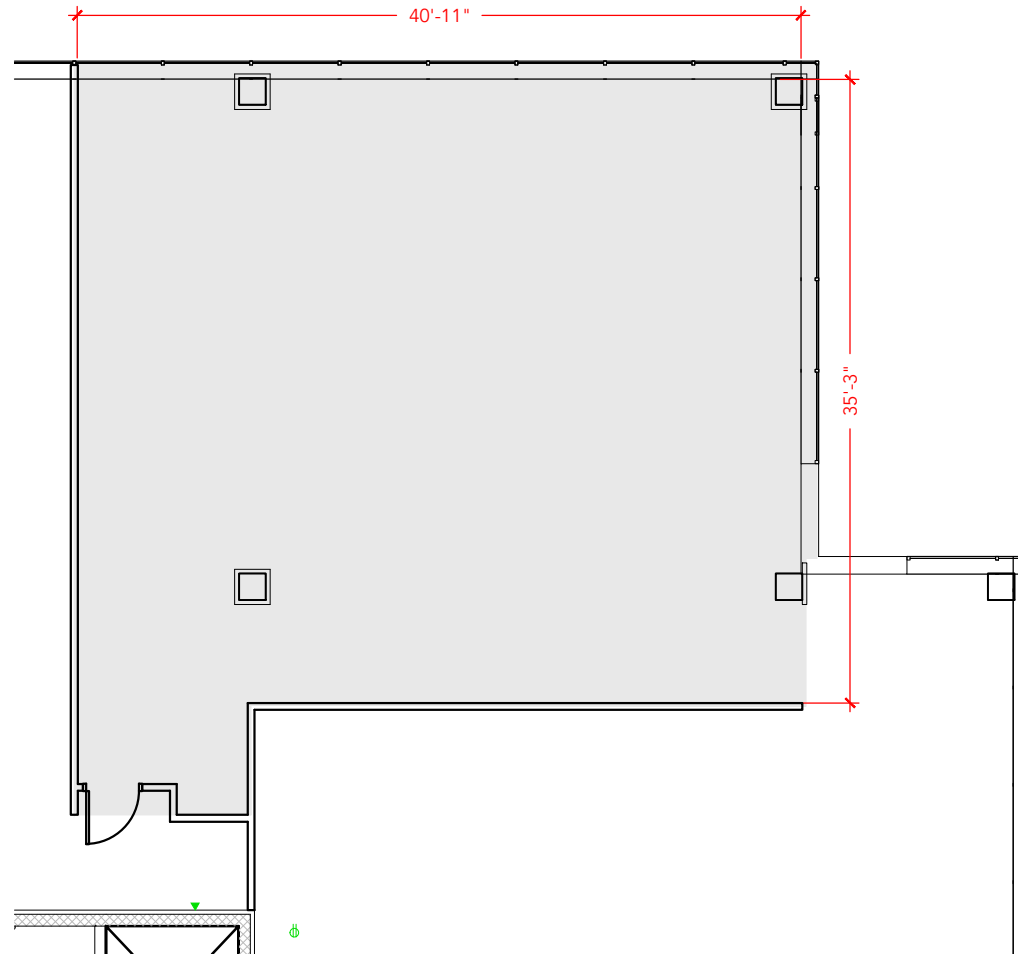

Floor Plan