



TOTAL SF AVAILABLE - 3,013 RSF (16%)

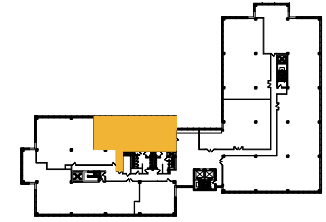

Key Plan

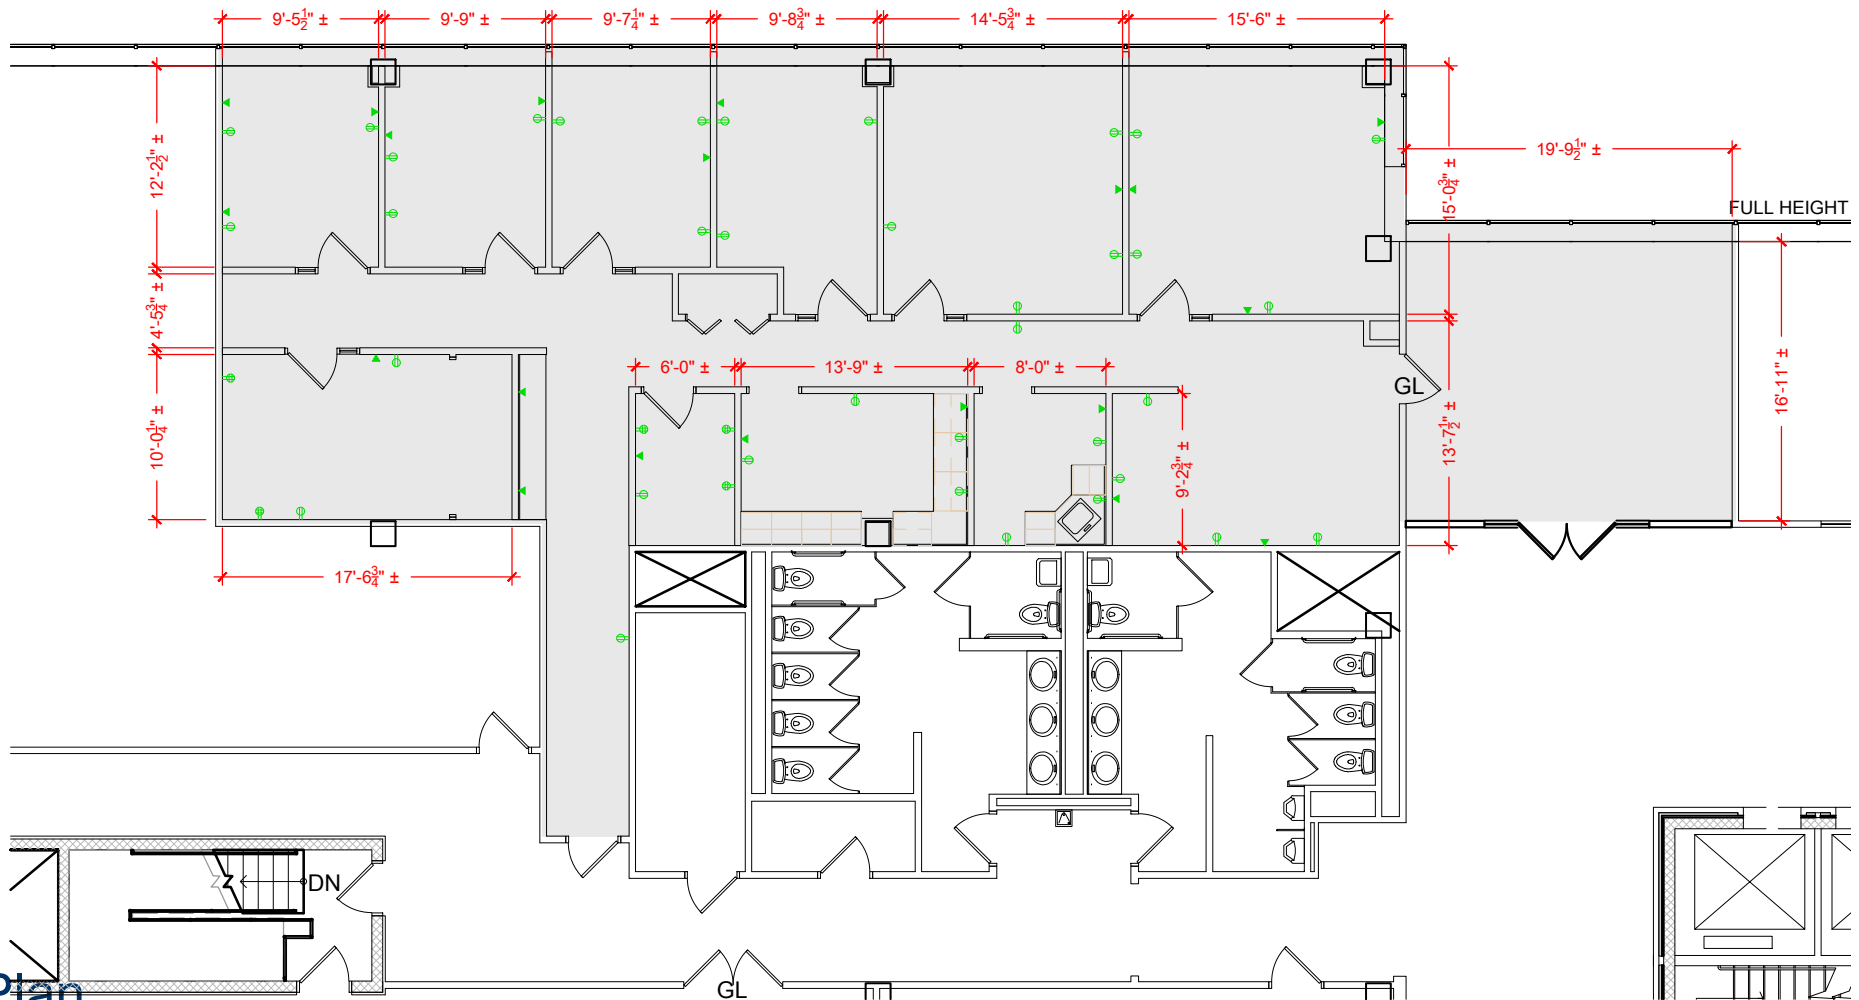

Floor Plan