



TOTAL SF AVAILABLE - 10,570 RSF(12%)

FULL FLOOR - 11,329 RSF(12%)

[Click to access 3D model](#)

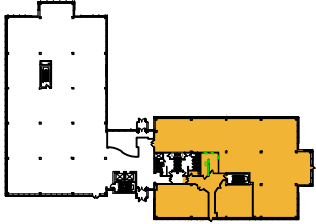

Key Plan

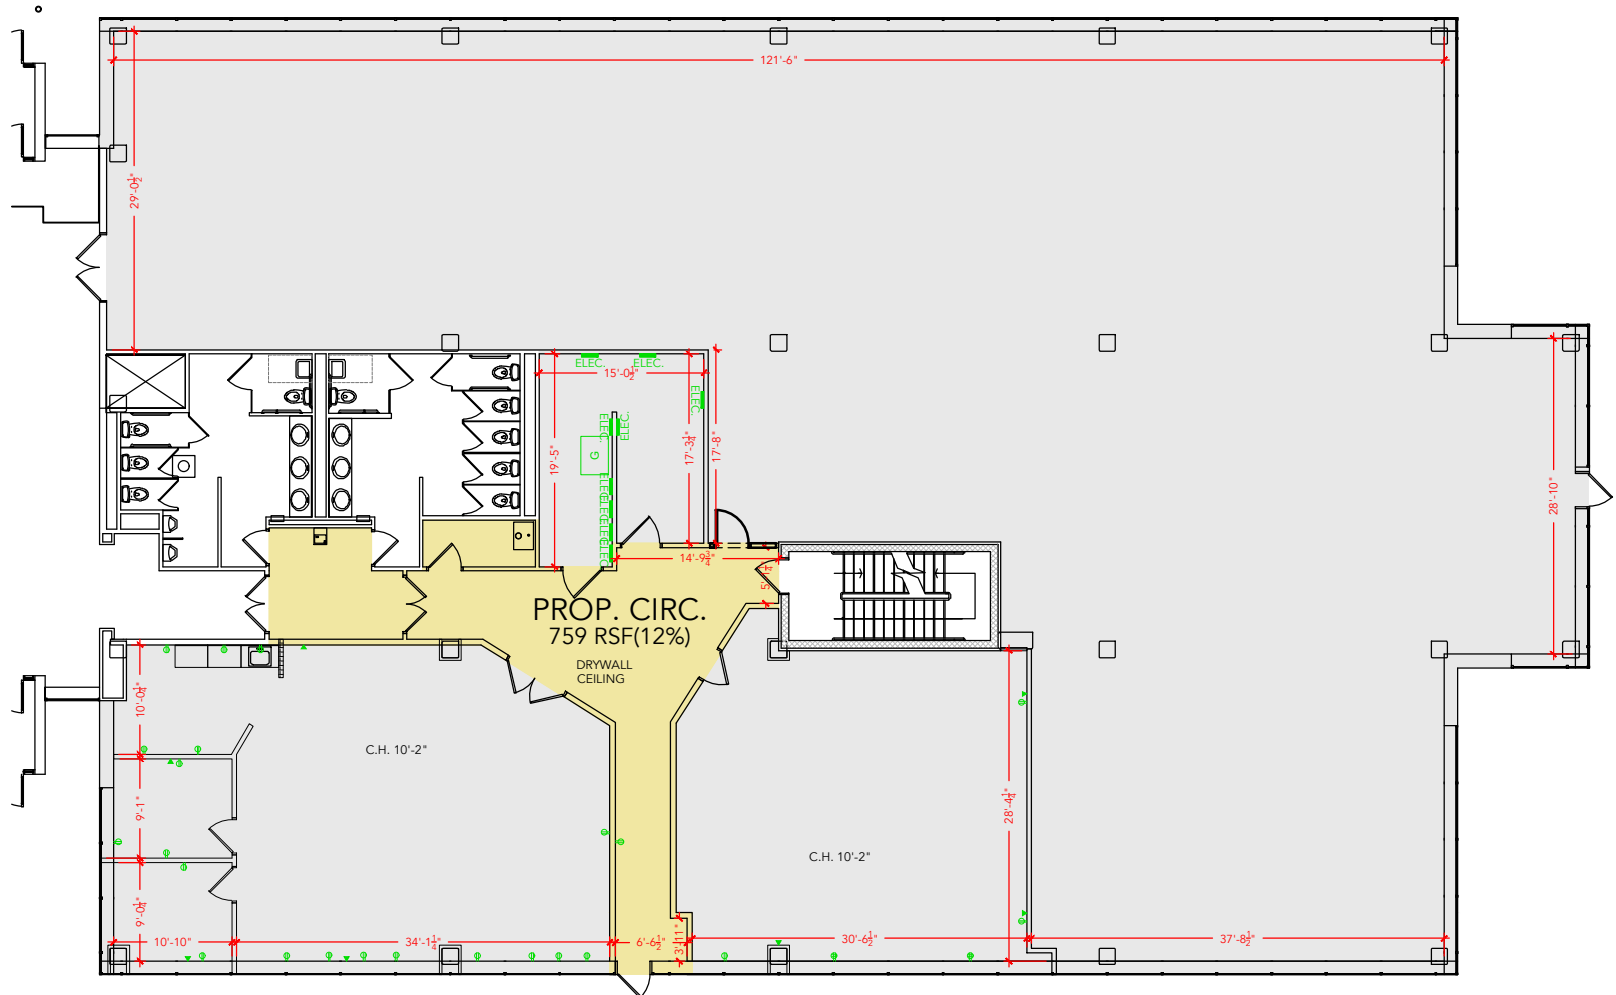

Floor Plan