


TOTAL SF AVAILABLE - 10,570 RSF(12%)


[Click to access 3D model](#)

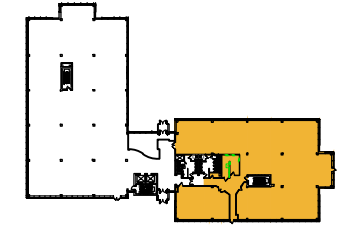

Key Plan

SUITES 150-180
9,068 RSF (12%)

SUITE 190
1,502 RSF (12%)

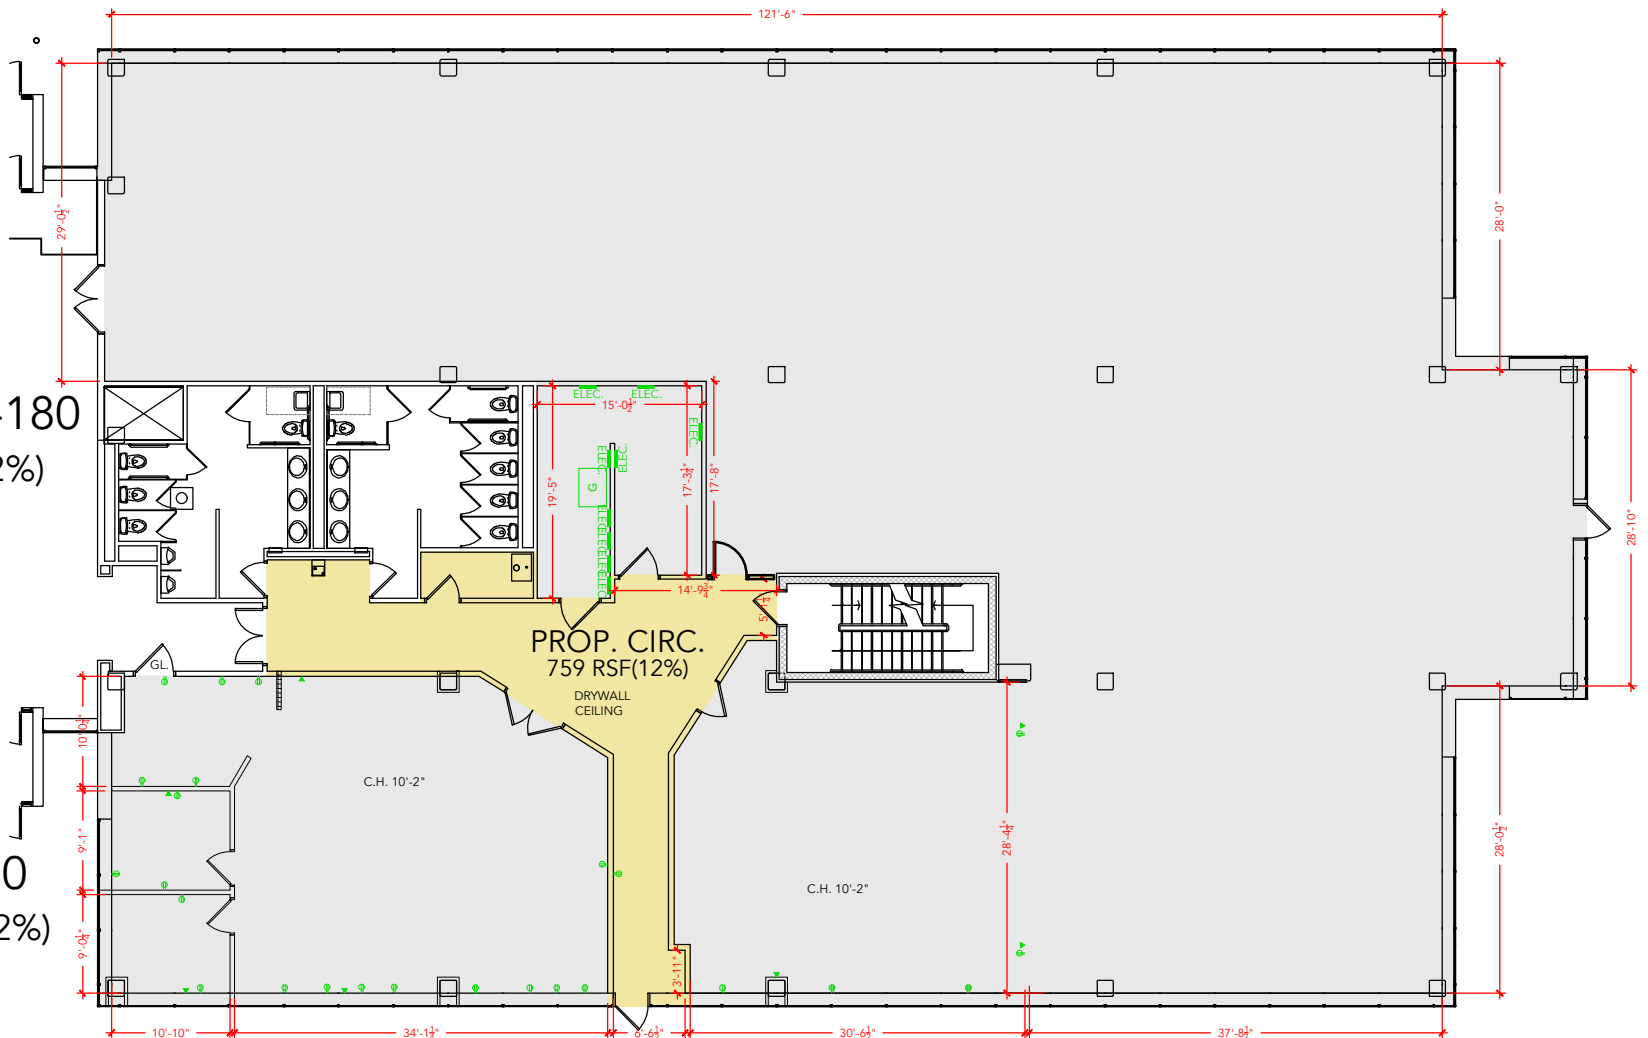

Floor Plan